

**KERR-MCGEE OIL AND GAS ONSHORE LP**

**ROLLIE J VINCENT UNIT 1**

**SW SW 12 2N 67W -- --**

**WELD,COLORADO**

**11/26/2013**

**AREA: S1**

**ROUTE: S12 Spud: 07/17/1974**

**WINS No.: 74383**

**AFE/WO#: 2089887**

**API#: 0512308088**

**GL: 4853**

**KB: 4864**

**MTD: 7990**


**TVD: 7990**

**LOG MD: 7985**

**PBMD: 7918**

**PBTVD: 7918**

**Directions: WCR 22-1/2 & WCR 23, E 1/2, S 1/4, SW INTO**

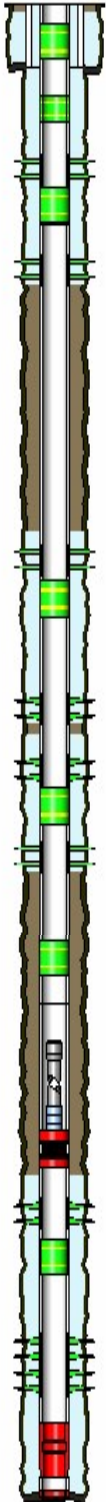

<u>HOLE SECTIONS</u>	<u>Size</u>	<u>Top</u>	<u>Btm</u>	<u>TD Date</u>				
SURFACE	12.25	11	210	07/16/1974				
PRODUCTION	7.88	210	7990	07/25/1974				
<u>TUBULARS</u>	<u>Tool Type</u>	<u>Joints</u>	<u>Size</u>	<u>Weight</u>	<u>Grade</u>	<u>Thread</u>	<u>Top D</u>	<u>Bottom D</u>
SURFACE CASING	Casing	6	8.63	24	K-55		11	190
PRODUCTION CASING	Casing	16	4.50	10.50	J-55	8RD	11	514
	Cement Stage Too	1	4.50				514	515
	Casing	13	4.50	10.50	J-55	8RD	515	925
	Casing	137	4.50	10.50	CW-55		925	6598
	Casing	42	4.50	11.60	K-55		6598	7951
	Casing Float Collar	1	4.50				7951	7953
	Casing	1	4.50	11.60	K-55		7953	7984
	Casing Guide Shoe	1	4.50				7984	7985
BRIDGE PLUG	Cast Iron Bridge Plu	1	4.00				7490	7490
PRODUCTION TUBING	Tubing	1	2.38	4.70	J-55	8RD EUE	7012	7018
	Seating Nipple	1	2.38				7018	7019
	Retrievable	1	4.50		2-3/8		7019	7024
DRIVE PIPE		1	3.75	O.D	WASH PIPE		7000	7003
CAST IRON CEMENT RETAINER	Cement Retainer		4.50				5358	5360
BRIDGE PLUG	Cast Iron Bridge Plu		4.50				6300	6302
CAST IRON CEMENT RETAINER	Cement Retainer		4.50				4150	4152
CAST IRON CEMENT RETAINER	Cement Retainer		4.50				905	907
BRIDGE PLUG	Cast Iron Bridge Plu		4.50				110	112
<u>CEMENT JOBS</u>	<u>Stage</u>	<u>Sacks</u>	<u>Cement Jobs</u>			<u>Top D</u>	<u>Btm D</u>	<u>cbl</u>
SURFACE CASING	STAGE 1	175		REGULAR		50	210	No
PRODUCTION CASING	STAGE 1	200	LEAD	50/50 POZ-MIX		7100	7990	Yes
	PRIM CMT 2ND STAGE	200	TAIL	50/50 POZ-MIX		11	579	Yes
	SQUEEZE JOB	375		REGULAR		11	650	Yes
PRODUCTION CASING	ABANDONMENT PLUC	90	LEAD	FRESH WATER		5100	5551	No
PRODUCTION CASING	ABANDONMENT PLUC	150	LEAD	FRESH WATER		275	1251	No
PRODUCTION CASING	ABANDONMENT PLUC	670	LEAD	FRESH WATER		3940	4991	No
<u>PERFORATIONS</u>	<u>Zone</u>	<u>Top</u>	<u>Btm</u>	<u>Date</u>	<u>Reason</u>	<u>Comments</u>		
		650	651	02/05/1992	CEMENT SQUEEZE			
		875	877	11/15/2013	CEMENT SQUEEZE			

## KERR-MCGEE OIL AND GAS ONSHORE LP

ROLLIE J VINCENT UNIT 1

SW SW 12 2N 67W -- --

WELD,COLORADO

11/26/2013

AREA: S1

ROUTE: S12

Spud: 07/17/1974

WINS No.: 74383

AFE/WO#: 2089887

API#: 0512308088

GL: 4853KB: 4864MTD: 7990TVD: 7990LOG MD: 7985PBMD: 7918PBTVD: 7918Directions:

WCR 22-1/2 &amp; WCR 23, E 1/2, S 1/4, SW INTO

	1250	1251	11/15/2013	CEMENT SQUEEZE
	4085	4087	11/14/2013	CEMENT SQUEEZE
	4990	4991	11/14/2013	CEMENT SQUEEZE
	5325	5327	11/12/2013	CEMENT SQUEEZE
	5550	5551	11/12/2013	CEMENT SQUEEZE
CODELL	7362	7382	09/21/1993	PRODUCTION
J SAND	7798	7814	08/29/1974	PRODUCTION
J SAND	7822	7842	08/29/1974	PRODUCTION

Comments: