


Well Name: KIRCHNER 01

Original Hole, 12/3/2013 7:32:07 AM

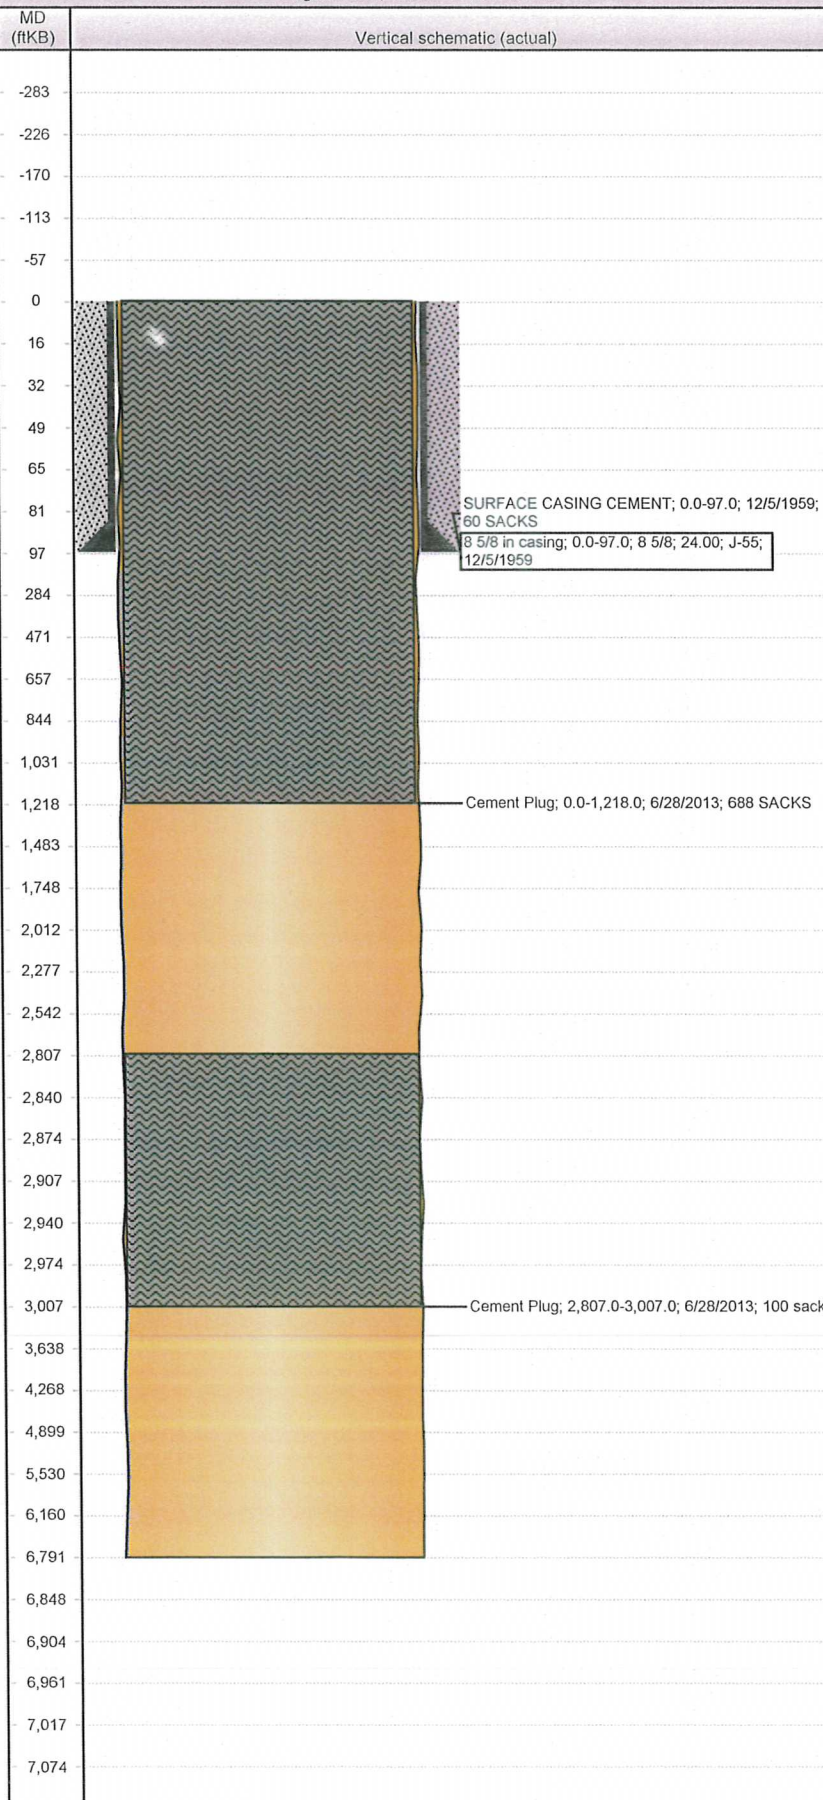

## Well Header

API	Business Unit	District	Well Config
05-123-05575	WATTENBERG	15	
Orig KB Elev (ft)	KB - GL / MSL (ftKB)	Spud Date	P & A Date
		11/20/1959	7/1/2013

Comment  
IHS 297 Well Data Import  
Formation at total depth: 602dkotj  
Initial well class: 5  
Final well class: 0  
Completion date: December 06, 1959  
Lat/Long source: s  
Directional indicator: v

## Surface Location (Congressional)

Quarter 1	Quarter 2	Quarter 3	Quarter 4	Section	Township	Twtnshp...	Range	Rng E/...
-----------	-----------	-----------	-----------	---------	----------	------------	-------	-----------

## Bottom Hole Location

North-South Distance (ft)	From N or S Line	East-West Distance (ft)	From E or W Line
---------------------------	------------------	-------------------------	------------------

## Zone Statuses

Zone Name	Status Date	Status	Com
-----------	-------------	--------	-----

## Casing Strings

Csg Des	Run Date	OD (in)	Wt/Len (lb/ft)	Grade	Top, MD (ftKB)	MD (ftKB)
8 5/8 in casing	12/5/1959	8 5/8	24.00	J-55	0.0	97.0

## Perforation Data

Zone	Bnch/St g	Entered Shot Total	Top (ftKB)	Btm (ftKB)	Date
------	-----------	--------------------	------------	------------	------