


**WELL NAME:** Drake 11-20  
**OPERATOR:** Scout Energy Corporation  
**COMP ZONE:** Dry Hole  
**LOCATION:** 9N 58W S20 NE SW

**COUNTY:** Weld  
**STATE:** Colorado  
**API :** 05-123-16817

**SPUD:** 2/19/93  
**P&A:** 2/25/93  
**GL:** 4,865'

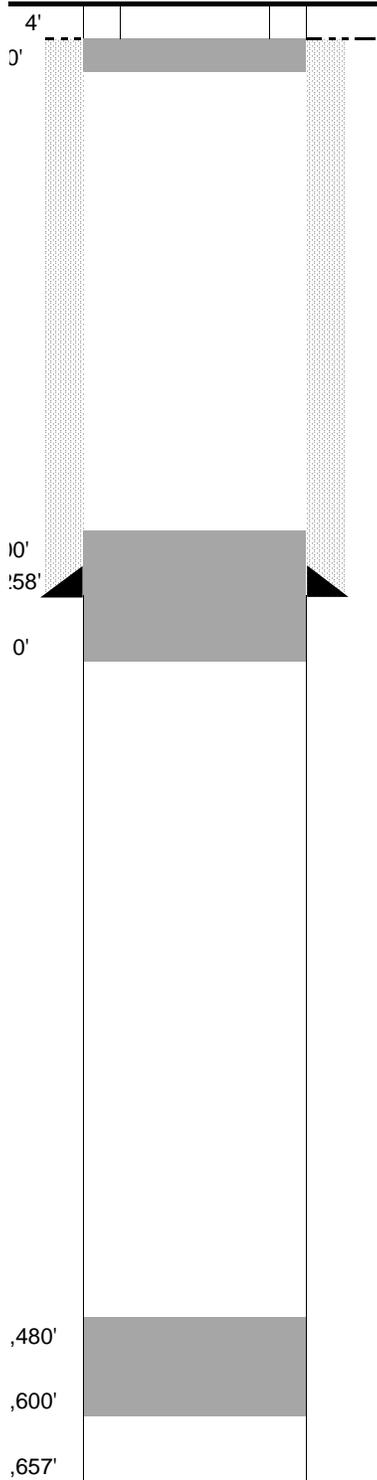

**SURFACE CASING**

DEPTH: 258' SIZE: 8.625" GRADE: \_\_\_\_\_ WT (#/ft): 24.0  
 CEMENT: 150 sx  
 COMMENTS: \_\_\_\_\_

**PRODUCTION CASING**

DEPTH: \_\_\_\_\_ SIZE: \_\_\_\_\_ GRADE: \_\_\_\_\_ WT (#/ft): \_\_\_\_\_  
 CEMENT: \_\_\_\_\_ TOC: \_\_\_\_\_  
 COMMENTS: \_\_\_\_\_

PERFS: \_\_\_\_\_ - \_\_\_\_\_ PROD ZONE 1: \_\_\_\_\_  
 PERFS: \_\_\_\_\_ - \_\_\_\_\_ ZONE 2: \_\_\_\_\_  
 PERFS: \_\_\_\_\_ - \_\_\_\_\_ ZONE 3: \_\_\_\_\_

**PLUGGING REPORT**

ZONE 1 CIBP: \_\_\_\_\_ CMT: \_\_\_\_\_ OTHER: \_\_\_\_\_  
 2 CIBP: \_\_\_\_\_ CMT: \_\_\_\_\_ OTHER: \_\_\_\_\_  
 3 CIBP: \_\_\_\_\_ CMT: \_\_\_\_\_ OTHER: \_\_\_\_\_

RECOVERED: \_\_\_\_\_ SIZE: \_\_\_\_\_  
 CMT 1: 6,600' - 6,480' COMMENT: 40 sx Cement  
 CMT 2: 310' - 200' COMMENT: 40 sx Cement  
 CMT 3: 30' - 0' COMMENT: 10 sx Cement

OTHER: cut all casing strings 4' below ground level, weld on plate

**FORMATIONS:**

NIOBRARA: 5,760'  
 FORT HAYS \_\_\_\_\_  
 CODELL \_\_\_\_\_  
 D SAND 6,518'  
 D SILT \_\_\_\_\_  
 J SAND 6,604'