


Well Name: BIBO STATE 01

Original Hole, 12/3/2013 8:05:29 AM

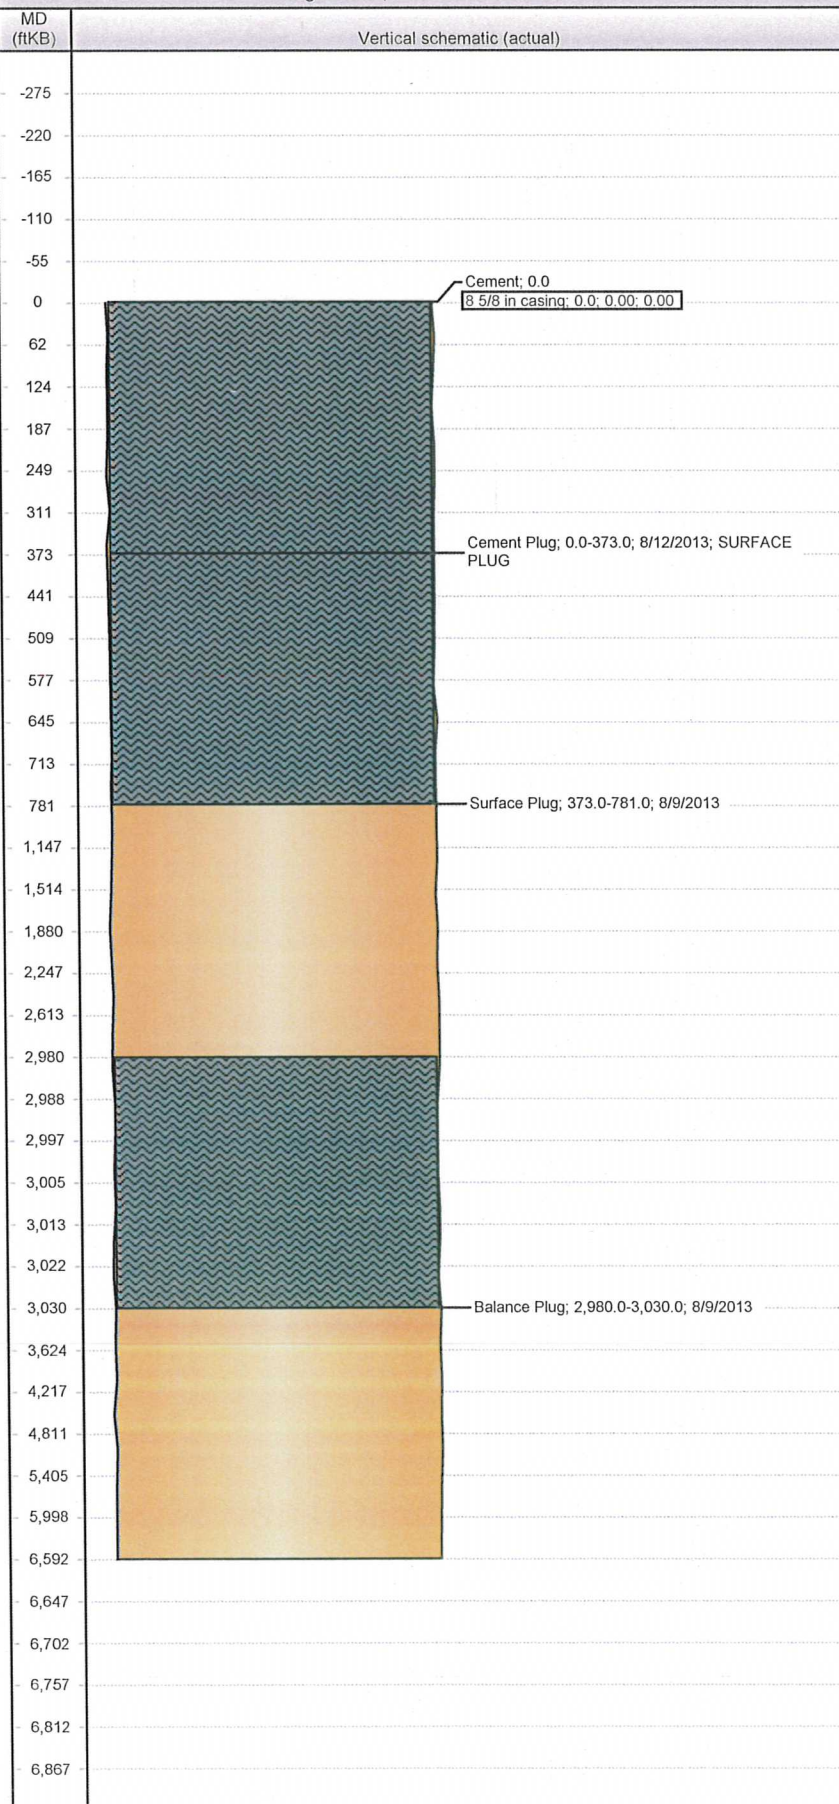

Well Header

API 05-123-10961	Business Unit WATTENBERG	District 15	Well Config
Orig KB Elev (ft)	KB - GL / MSL (ftKB)	Spud Date 12/7/1982	P & A Date 11/8/2013

Comment
IHS 297 Well Data Import
Formation at total depth: 602dkotj
Initial well class: 5
Final well class: 0
Completion date: December 17, 1982
Lat/Long source: s
Directional indicator: v

Surface Location (Congressional)

Quarter 1	Quarter 2	Quarter 3	Quarter 4	Section	Township	Twnshp...	Range	Rng E/...
-----------	-----------	-----------	-----------	---------	----------	-----------	-------	-----------

Bottom Hole Location

North-South Distance (ft)	From N or S Line	East-West Distance (ft)	From E or W Line
---------------------------	------------------	-------------------------	------------------

Zone Statuses

Zone Name	Status Date	Status	Com

Casing Strings

Csg Des	Run Date	OD (in)	W/Len (lb/ft)	Grade	Top, MD (ftKB)	MD (ftKB)
8 5/8 in casing						

Perforation Data

Zone	Bnch/St g	Entered Shot Total	Top (ftKB)	Btm (ftKB)	Date