


**WPX Energy Rocky Mountain LLC
FEDERAL PA 11-27
Parachute Field**

**SHL 2075' FNL 1304' FWL (SW/4 NW/4) LOT 6 Section 27 T7S R95W 6th PM
BHL 139' FNL 615' FWL (NW/4 NW/4) Section 27 T7S R95W 6th PM
Garfield County Colorado**

**Formation Tops
(Measured Depths)**

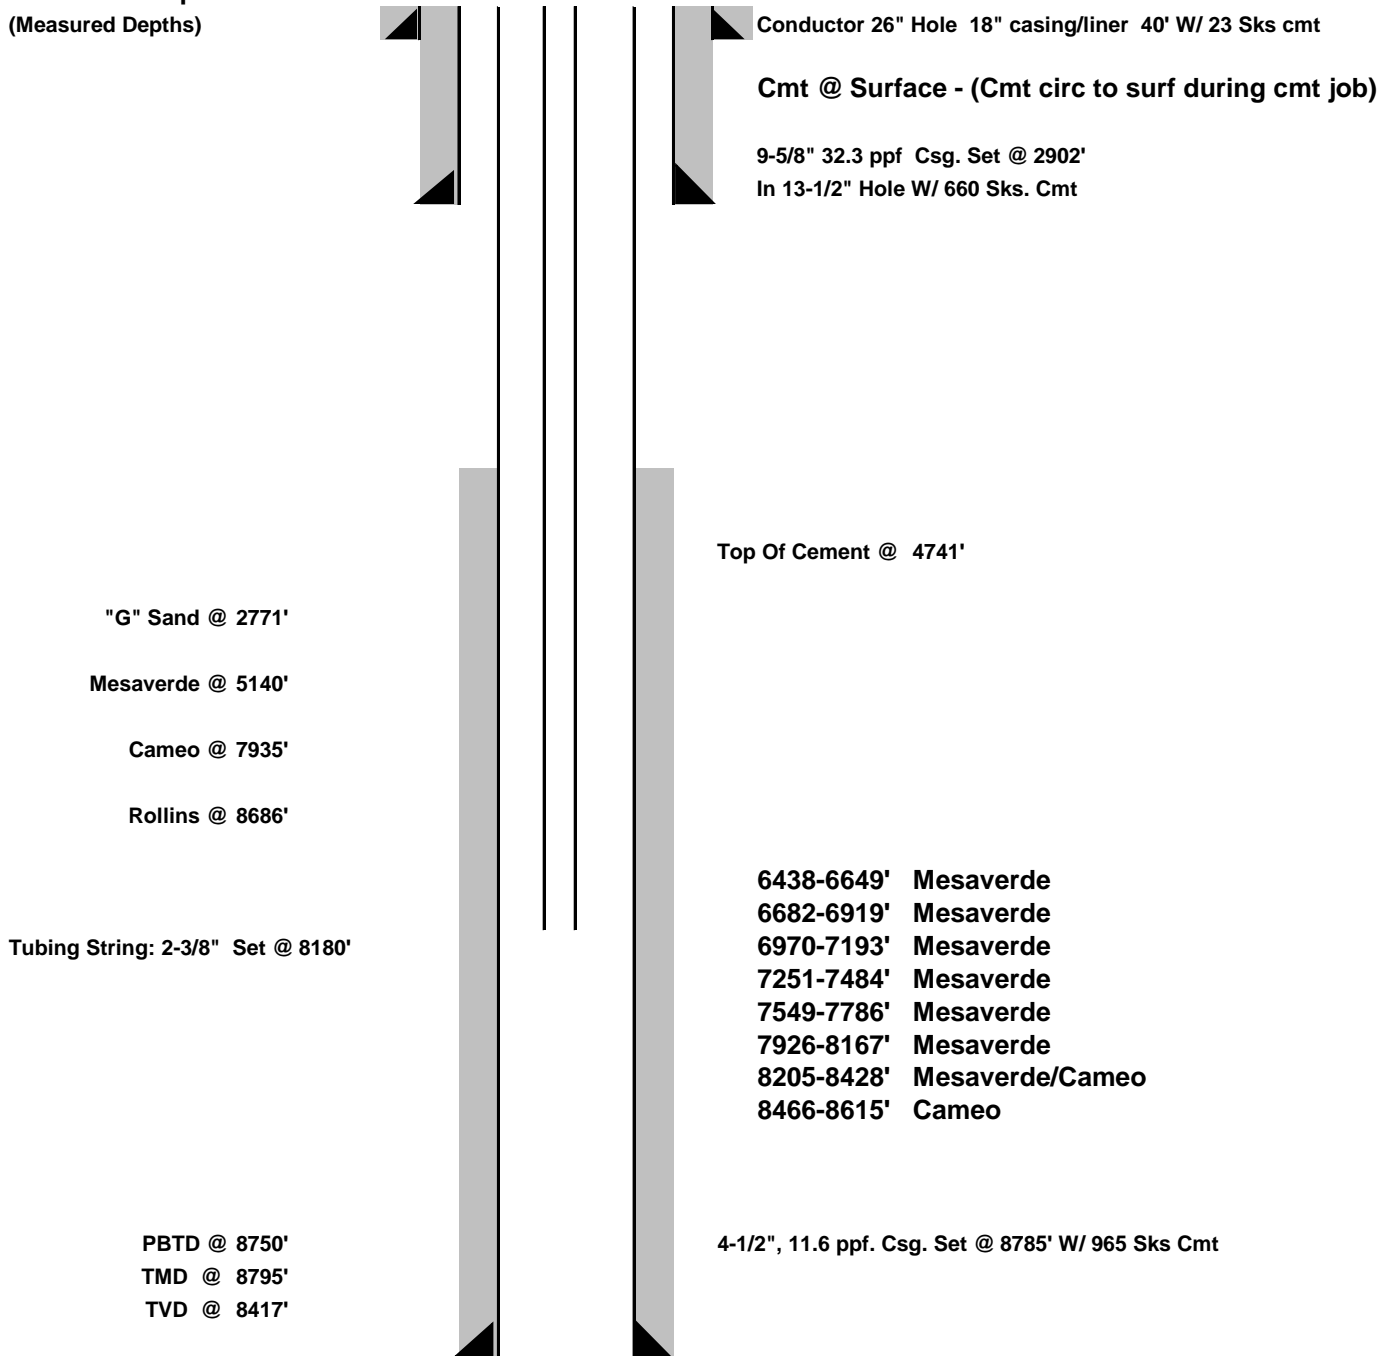

DATE CREATED: 11/21/2013

NOTE: THIS IS NOT TO SCALE.
****FINAL****