


KERR-MCGEE OIL AND GAS ONSHORE LP
WITTEMEYER 7-2A
SW NE 2 2N 67W 2,031' FNL 2,104' FEL
WELD,COLORADO
12/03/2013

AREA: S1 ROUTE: S12 Spud: 02/01/2000 WINS No.: 74791 AFE/WO#: 00085705 API#: 0512319898

GL: 4851 KB: 4863 MTD: 7972 TVD: 7972 LOG MD: 7924 PBMD: 7920 PBTVD: 7920

Directions: **WCR 21-1/2 & WCR 24-1/2, N 2/10, E INTO**

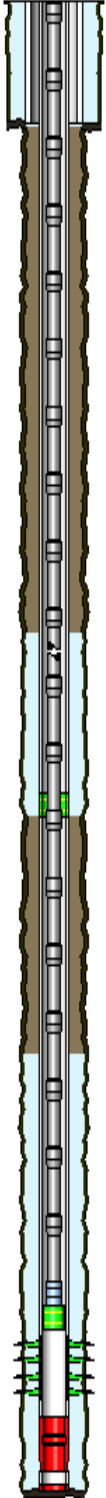

HOLE SECTIONS		Size	Top	Btm	TD Date	
SURFACE		12.25	12	777	02/01/2000	
PRODUCTION		7.88	777	7972	02/06/2000	

TUBULARS	Tool Type	Joints	Size	Weight	Grade	Thread	Top D	Bottom D
SURFACE CASING								
	Casing	18	8.63	24.00	J-55	STC	12	767
PRODUCTION CASING								
	Casing	116	4.50	11.60	I-80	LTC	12	4905
	Cement Stage Too	1	4.50				4905	4910
	Casing	71	4.50	11.60	I-80	LTC	4910	7920
	Float Collar	1	4.50				7920	7922
	Casing	1	4.50	11.60	I-80	LTC	7922	7949
	Casing Shoe	1	4.50				7949	7950
PRODUCTION TUBING								
	Tubing	249	2.37	4.70	J-55	External-Ups	12	7784
	Seating Nipple	1	2.38		J-55		7784	7785
	Notched Collar	1	3.06		J-55		7785	7786

CEMENT JOBS	Stage	Sacks	Cement Jobs	Top D	Btm D	cbl
SURFACE CASING						
	STAGE 1	540	NEAT	12	777	No
PRODUCTION CASING						
	STAGE 2	250	50/50 POZ-MIX	3912	4600	Yes
	STAGE 2 TAIL	50	G	4600	4910	Yes
	STAGE 1	300	G	6370	7972	Yes

PERFORATIONS						
Formation	Zone	Top	Btm	Date	Reason	Comments
J SAND		7820	7830	02/17/2000	PRODUCTION	
J SAND		7840	7860	02/17/2000	PRODUCTION	

Comments: