


T4N, R62W, 6th PM

NOTE: Under Colorado law, you must commence any legal action based upon any defect in this certificate within three years after defect is discovered. In no event, may any action based upon any defect in this survey be commenced more than ten years after date of this certificate shown hereon. (13-80105 C.R.S.)

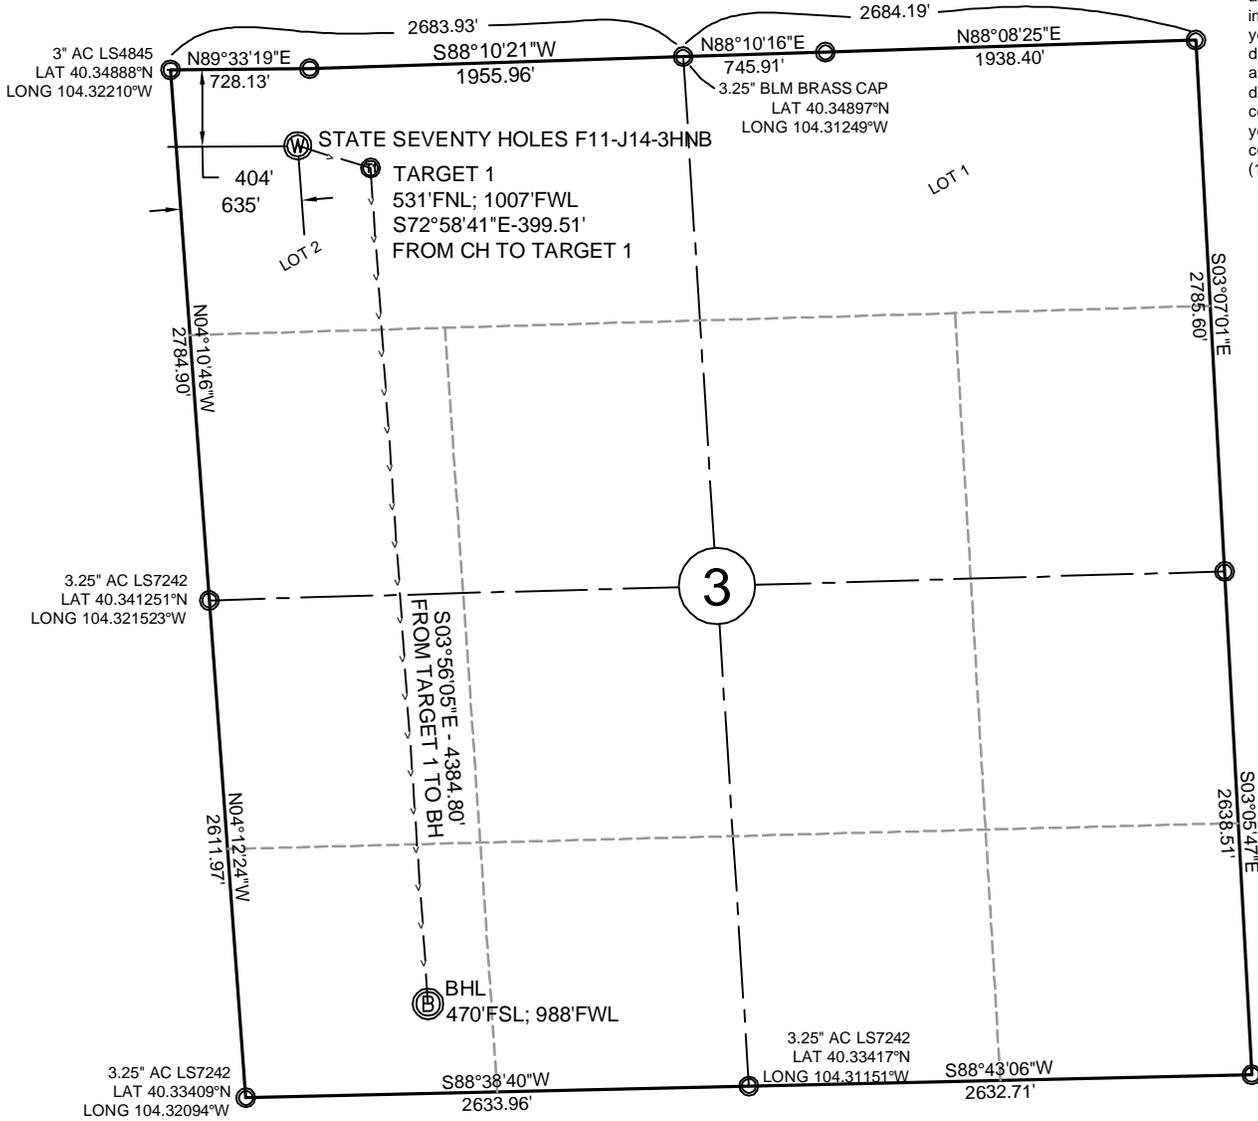

NOTES:

- All bearings are GRID based upon the Colorado State Plane Coordinate System, North Zone, NAD83(2011) derived from post-processed static GPS observations.
- Distances are at GROUND
- Vertical Datum is NAVD88 based upon GPS observations
- PDOP value equals 1.6.
- GPS operator: Dave Fehringer.
- Undisturbed ground elevation at wellhead = 4533.8'

CERTIFICATE OF SURVEYOR

I, David A. Fehringer of Lander, Wyoming hereby certify that this well location certificate was prepared from notes taken during an actual survey on SEPTEMBER 29, 2013, and that it correctly shows the drilling location of BONANZA CREEK ENERGY, INC., STATE SEVENTY HOLES F11-J14-3HNB as staked during said survey. This map does not represent a boundary survey or an improvement location plat and should not be used for the establishment of boundary lines.

SURFACE LOCATION: (NAD83)

GEODETIC COORDINATES
 LAT 40.347765°
 LONG 104.319753°

TARGET #1: (NAD83)

GEODETIC COORDINATES
 LAT 40.347430°
 LONG 104.318386°

BOTTOM HOLE LOCATION: (NAD83)

GEODETIC COORDINATES
 LAT 40.335412°
 LONG 104.317516°

STATE PLANE (CO-N NAD83)


N=1,371,721 ft
 E=3,328,955 ft

STATE PLANE (CO-N NAD83)

N=1,371,604 ft
 E=3,329,337 ft

STATE PLANE (CO-N NAD83)


N=1,367,229 ft
 E=3,329,638 ft

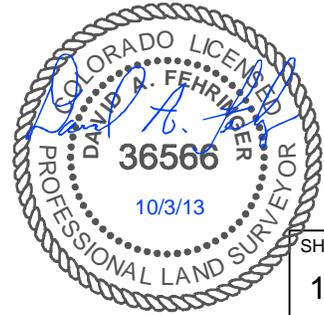

SHEET NO:
 1 of 1



Drawn By: DAF
 Checked By: DAF
 Date: 10/3/12
 Revision: #2
 Date: 10/16/12
 Explanation: Add ground elevations to well certification

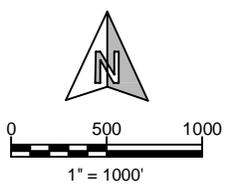

WELL LOCATION CERTIFICATE
 STATE SEVENTY HOLES F11-J14-3HNB
 404'FNL, 635'FWL
 NW¼NW¼, SECTION 3,
 T.4N., R.62W., 6th PM
 WELD COUNTY, COLORADO

