

Well Name: Debeque 08-08

API #: 05-077-08683-0000

Location: Sec. 8-97W-9S

KB: 4,896'


GL: 4,884'

County/St: Mesa, CO

Created By: B. Hoyer

Date: 12/03/2013

Current Wellbore

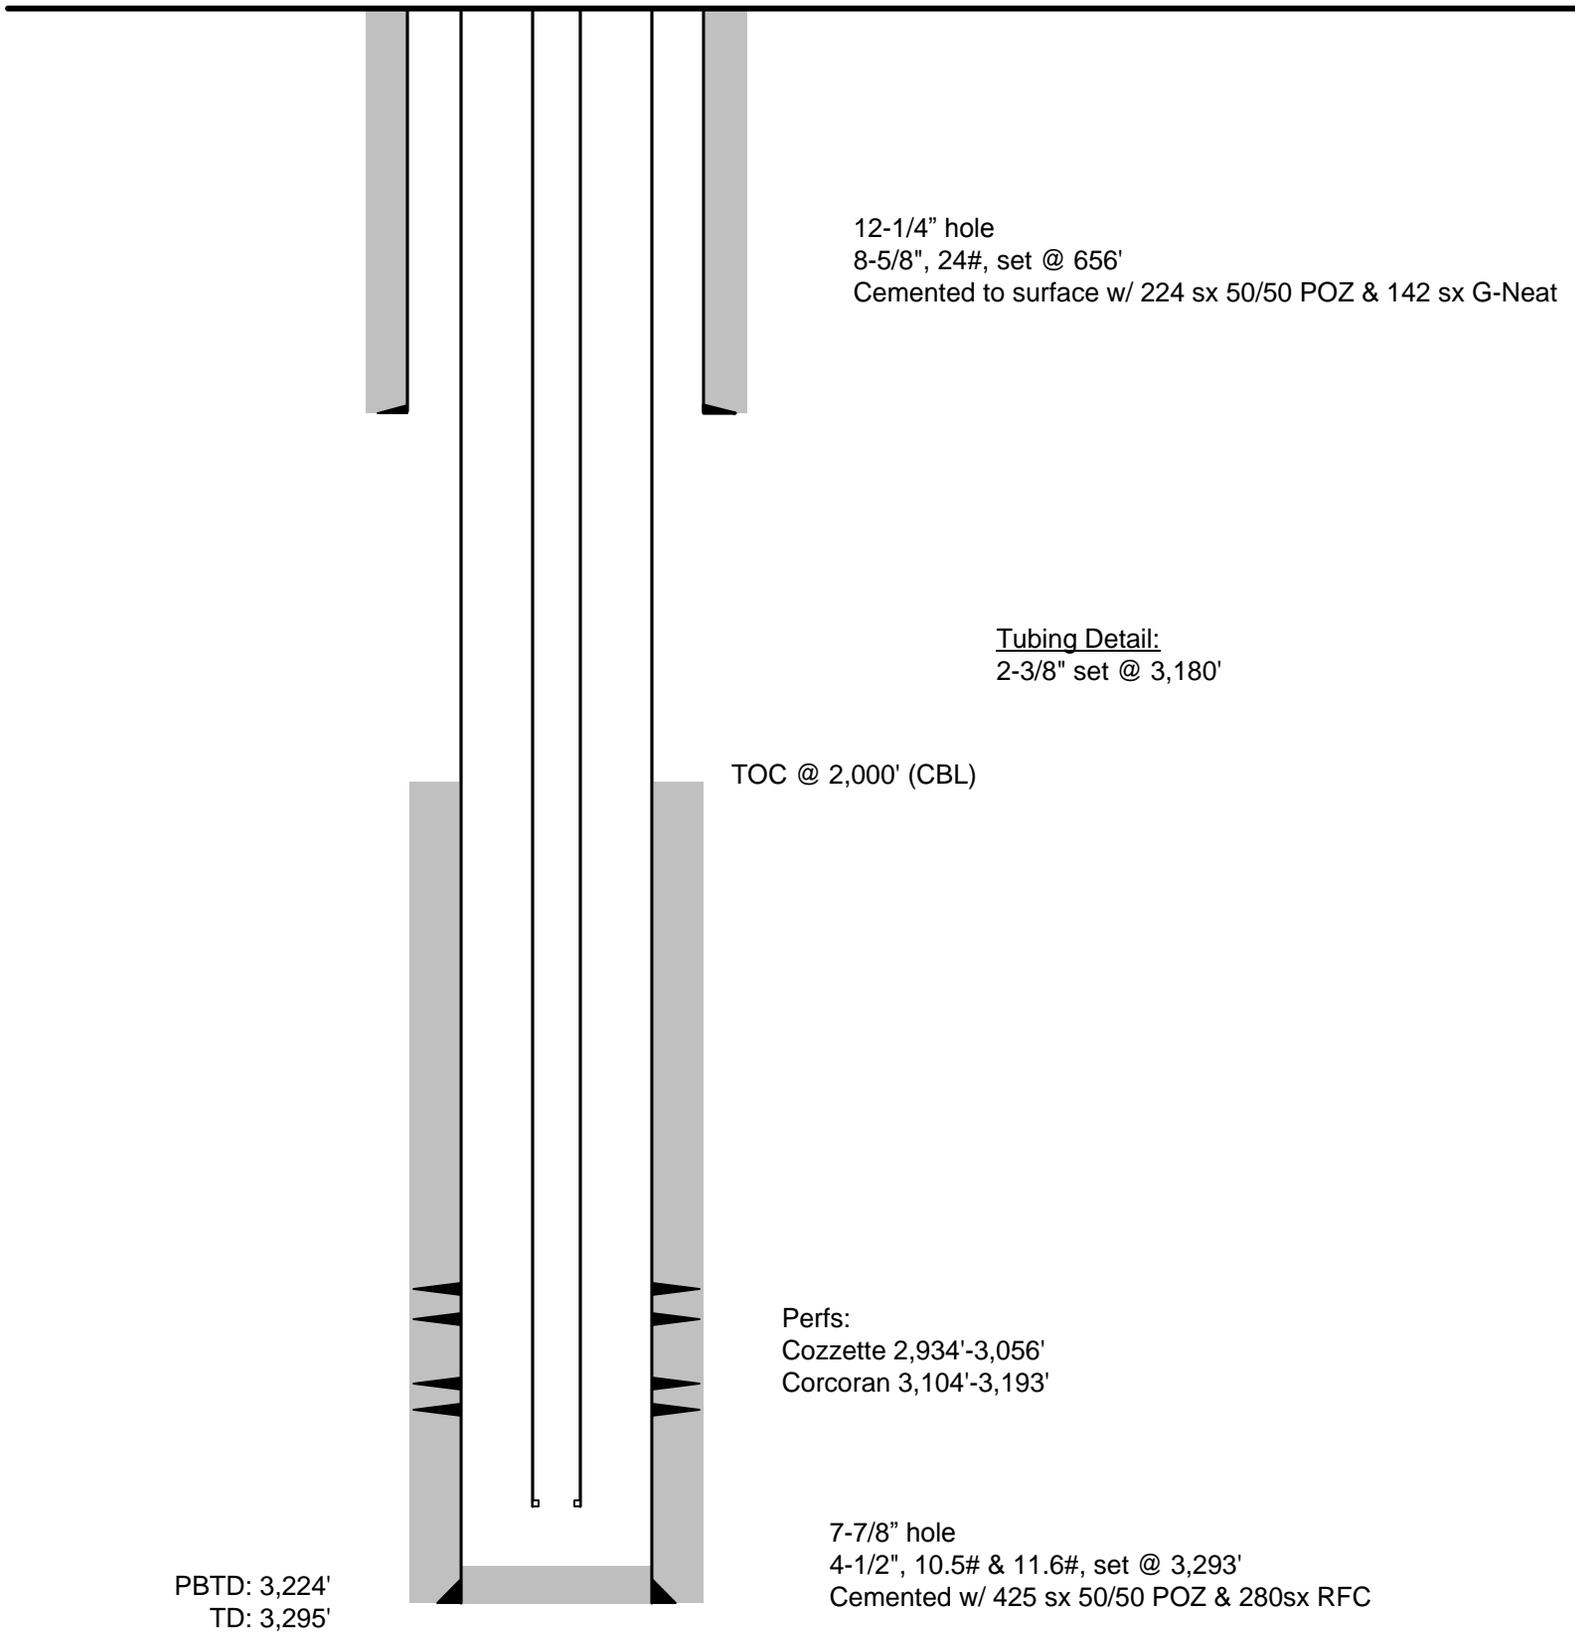

12-1/4" hole
8-5/8", 24#, set @ 656'
Cemented to surface w/ 224 sx 50/50 POZ & 142 sx G-Neat

Tubing Detail:
2-3/8" set @ 3,180'

TOC @ 2,000' (CBL)

Perfs:
Cozzette 2,934'-3,056'
Corcoran 3,104'-3,193'

7-7/8" hole
4-1/2", 10.5# & 11.6#, set @ 3,293'
Cemented w/ 425 sx 50/50 POZ & 280sx RFC

PBTD: 3,224'
TD: 3,295'