


**WPX Energy Rocky Mountain LLC
SAVAGE RWF 422-25
RULISON FIELD**

**SHL 2488' FNL 1405' FWL (SE/4 NW/4) Section 25 T6S R94W 6th PM
BHL 2072' FNL 2095' FWL (SE/4 NW/4) Section 25 T6S R94W 6th PM
Garfield County Colorado**

**Formation Tops
(Measured Depths)**

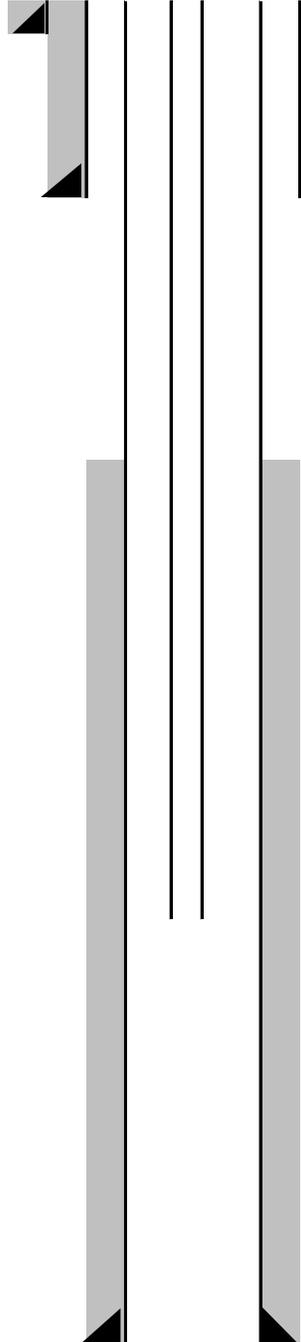

Conductor 26" Hole 18" casing/liner 63' W/ 24 Sks cmt

Cmt @ Surface - (Cmt circ to surf during cmt job)

9-5/8" 32.3 ppf Csg. Set @ 1133'
In 13-1/2" Hole W/ 380 Sks. Cmt

Top Of Cement @ 3694'

"G" Sand @ 2238'

Mesaverde @ 4757'

Cameo @ 7637'

Rollins @ 8512'

Tubing String: 2-3/8" Set @ 8126'

6393-6659' Mesaverde
6698-6854' Mesaverde
6906-7188' Mesaverde
7469-7747' Mesaverde
7787-8002' Mesaverde/Cameo
8105-8360' Cameo

PBTD @ 8600'
TMD @ 8680'
TVD @ 8615'

4-1/2", 11.6 ppf. Csg. Set @ 8663' W/ 1245 Sks Cmt

DATE CREATED: 12/16/2013

**NOTE: THIS IS NOT TO SCALE.
FINAL**