

WPX Energy Rocky Mountain LLC

SAVAGE RWF 512-25

RULISON FIELD


SHL 2487' FNL 1392' FWL (SE/4 NW/4) Section 25 T6S R94W 6th PM

BHL 1791' FNL 798' FWL (SW/4 NW/4) Section 25 T6S R94W 6th PM

Garfield County Colorado

Formation Tops

(Measured Depths)

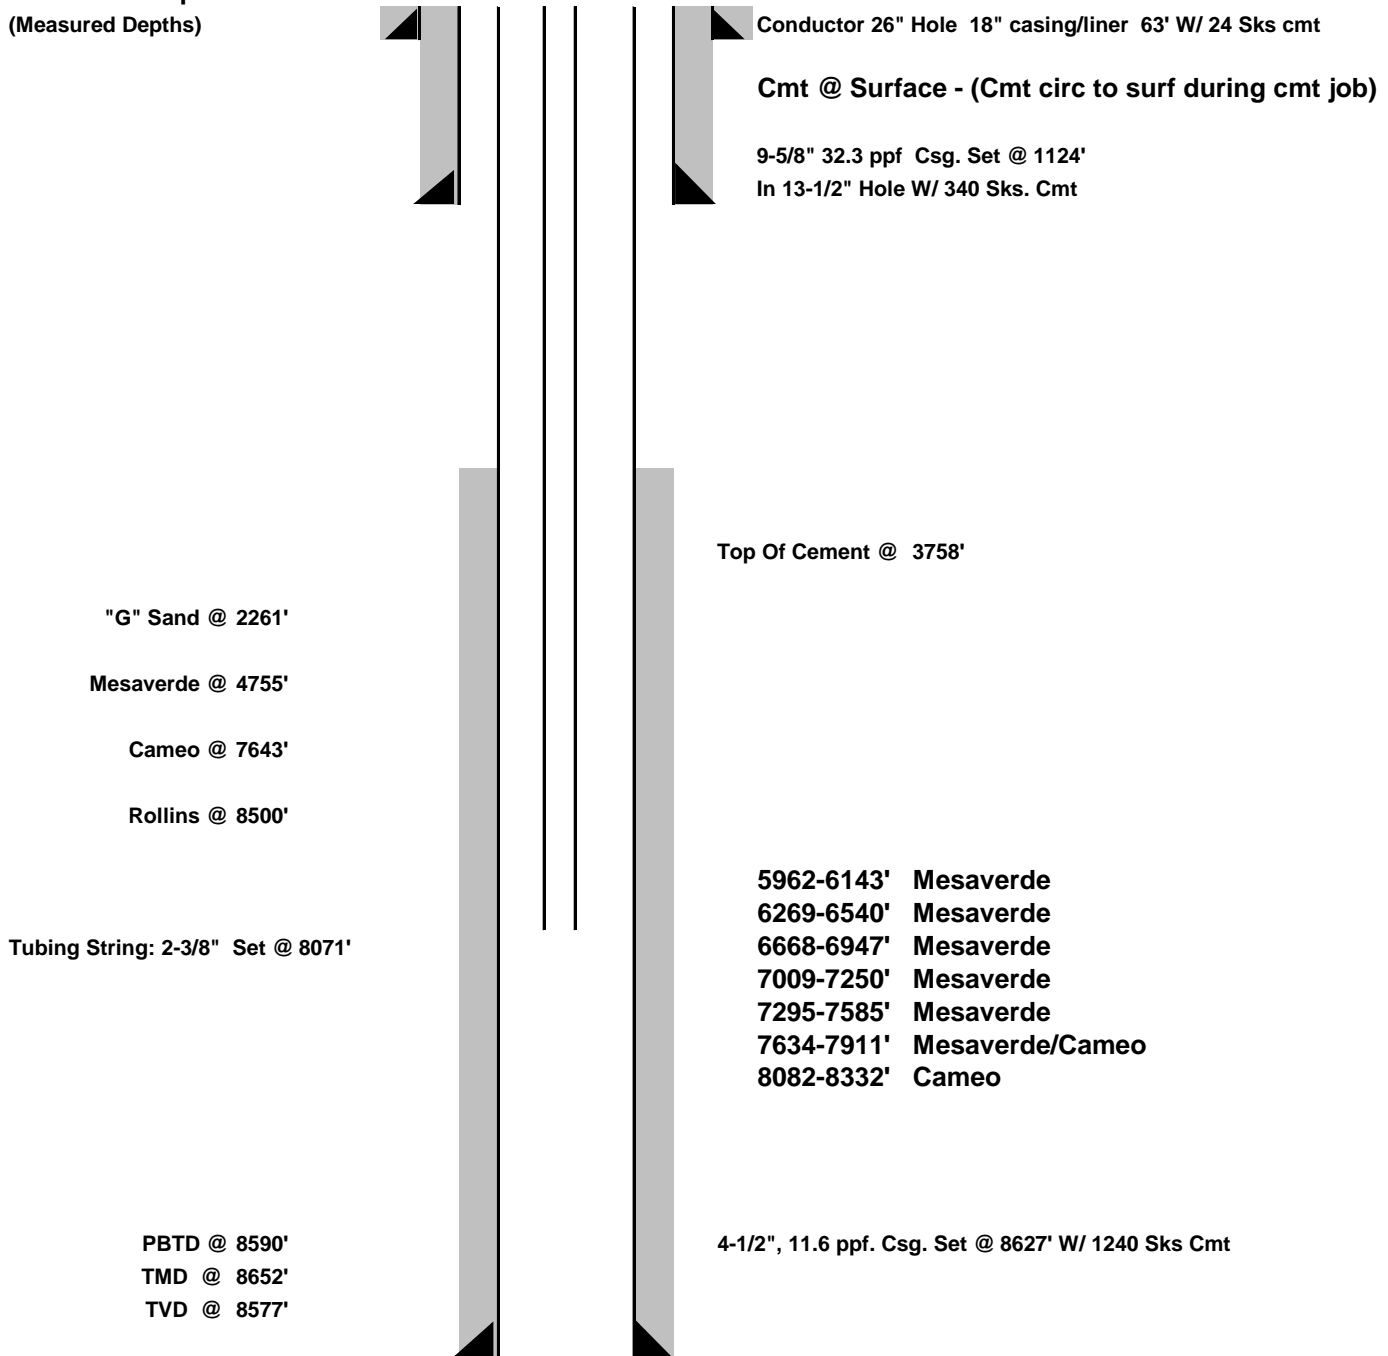

DATE CREATED: 12/16/2013

NOTE: THIS IS NOT TO SCALE.

****FINAL****