


Well Name: WASTE MANAGEMENT USX Y 03-13

VERTICAL - ORIGINAL HOLE, 12/18/2013 9:25:21 AM

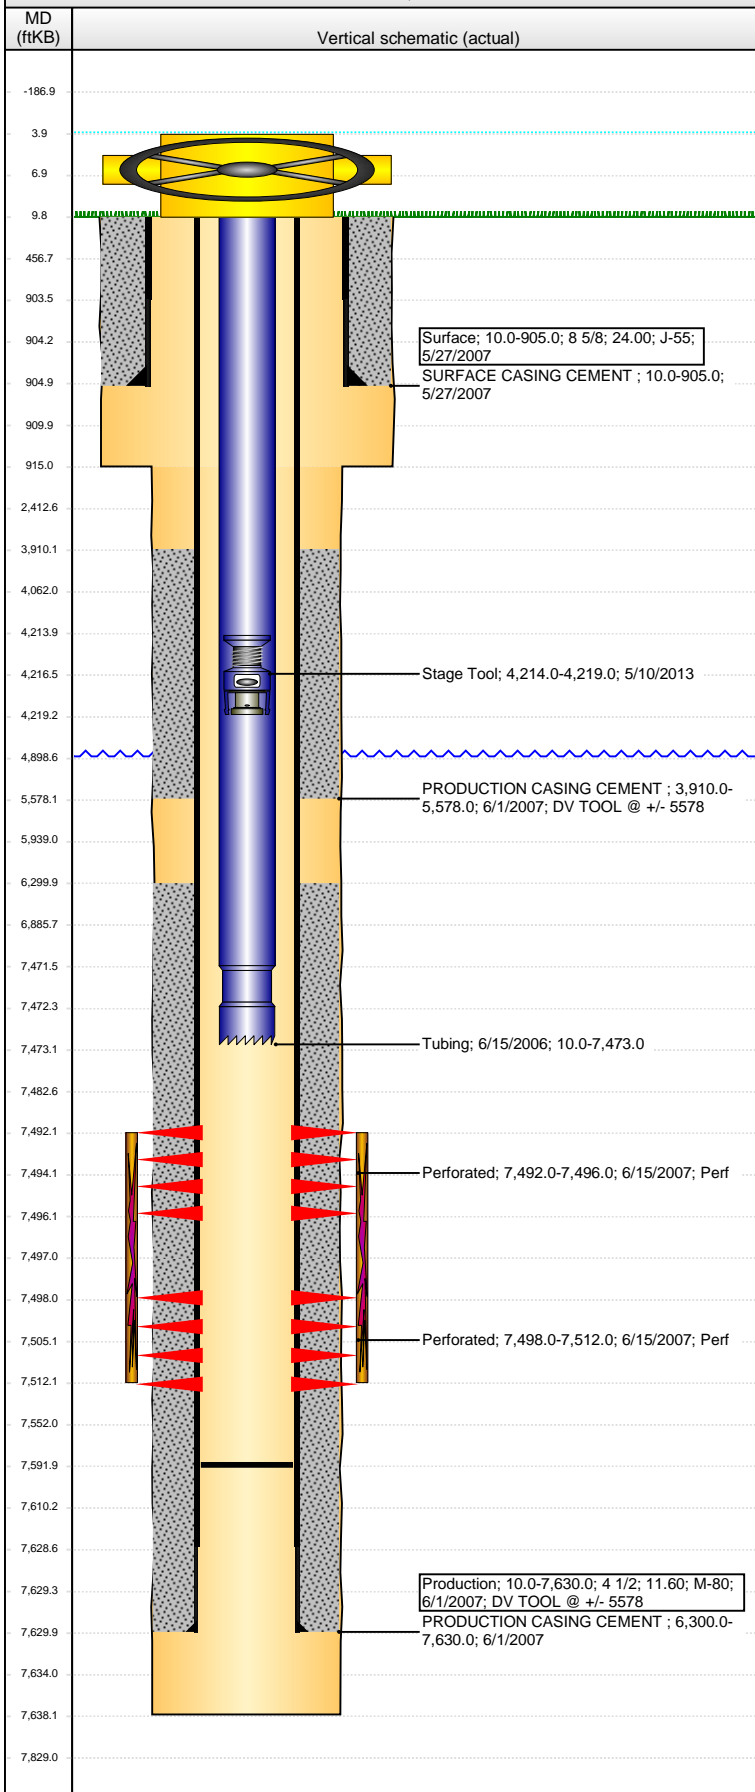

Well Header									
API 05-123-24798		Business Unit WATTENBERG		District 15		Well Config VERTICAL			
Original KB Elevation (ft) 4,889.00		KB - GL / MSL (ftKB) 10.00		Spud Date 5/26/2007		P & A Date			
Comment DV TOOL @ +/- 5578									
Directions To Well									
Congressional Location									
Quarter 1	Quarter 2	Quarter 3 SW	Quarter 4 SW	Section 3	Township 2 N	Twtnshp N...	Range 64	Rng E/W Dir W	
Bottom Hole Location									
North-South Distance (ft)		From N or S Line		East-West Distance (ft)			From E or W Line		
Plug Back Total Depths									
Date	Depth (ftKB)	Method			Com				
6/1/2007	7,612.0	CASING TALLY			GUIDE SHOE				
6/14/2007	7,600.0	TAG			CLEAN OUT				
6/15/2007	7,592.0	CASED HOLE LOG			DEPTH LOGGER FROM CBL				
Wellbore Sections									
Section Des			Size (in)		Act Top, MD (ftKB)		Act Btm, MD (ftKB)		
SURFACE			12 1/4		10.0		915.0		
PRODUCTION			7 7/8		915.0		7,638.0		
Zone Statuses									
Zone Name		Status Date		Status		Job			
J SAND		8/30/2007		PR		DRILLING/COMPLETION - ORIGINAL, 5/26/2007 00:00			
Casing Strings									
Surface, 905.0ftKB									
Casing Description Surface		Run Date 5/27/2007		OD (in) 8 5/8	Wt/Len (l...) 24.00	Grade J-55	Top, MD (ft...) 10.0	MD (ftKB) 905.0	
Production, 7,630.0ftKB									
Casing Description Production		Run Date 6/1/2007		OD (in) 4 1/2	Wt/Len (l...) 11.60	Grade M-80	Top, MD (ft...) 10.0	MD (ftKB) 7,630.0	
Cement									
Description SURFACE CASING CEMENT					Top Depth (ftKB) 10.0		Bottom Depth (ftKB) 905.0		
Description PRODUCTION CASING CEMENT					Top Depth (ftKB) 3,910.0		Bottom Depth (ftKB) 5,578.0		
Description PRODUCTION CASING CEMENT					Top Depth (ftKB) 6,300.0		Bottom Depth (ftKB) 7,630.0		
Tubing Components									
Item Des		OD (in)	Wt (lb/ft)	Grade	Jts	Len (ft)		Btm (ftKB)	Btm (TVD) (ftKB)
EUE 8rd Tubing		2 3/8	4.70	J-55	242	7,461.35		7,471.4	
Notched collar		2 3/8				1.65		7,473.0	
Perforation Data									
Zone		Bnch/St g	Entered Shot Total	Top (ftKB)		Btm (ftKB)		Date	
J SAND, ORIGINAL HOLE			16	7,492.00		7,496.00		6/15/2007	
J SAND, ORIGINAL HOLE			56	7,498.00		7,512.00		6/15/2007	
Stimulations & Treatments									
Date 7/6/2007		Zone J SAND, ORIGINAL HOLE			Primary Job Type DRILLING/COMPLETION - ORIGINAL				
Technical Result			Tech Result Details				Tech Result Note		
Comment									
Other In Hole									
Run Date		Des			OD (in)		Top (ftKB)		Btm (ftKB)
5/10/2013		Stage Tool			2		4,214.0		4,219.0
Logs									
Date		Type				Top, MD (ftKB)		Btm, MD (ftKB)	
6/1/2007		COMPENSATED DENSITY				2,850.0		7,611.0	
6/1/2007		INDUCTION				905.0		7,631.0	
6/15/2007		CBL/CCL/GR				3,780.0		7,590.0	