NOBLE ENERGY INC.

WASTE MANAGEMENT USX Y #3-6
SENW 3-2N-64W
2080' FNL & 2080' FWL
Weld County, Colorado
Wattenberg
CURRENT WELLBORE SCHEMATIC
with PROPOSED P&A
12/12/2013

API: 05-123-24791
COGCC #

GL Elev: 4892'
KB Elev: 4902

Spud Date: 6/26/2007

Surface Casing :
8 5/8" 24# @ 906'
Cement: 434 SX
TOC: Surface

TOC @ 3500'

Production Casing :
4 1/2" 11.6# @ 7186'
Cement: 660 SX
TD: 7/1/2007

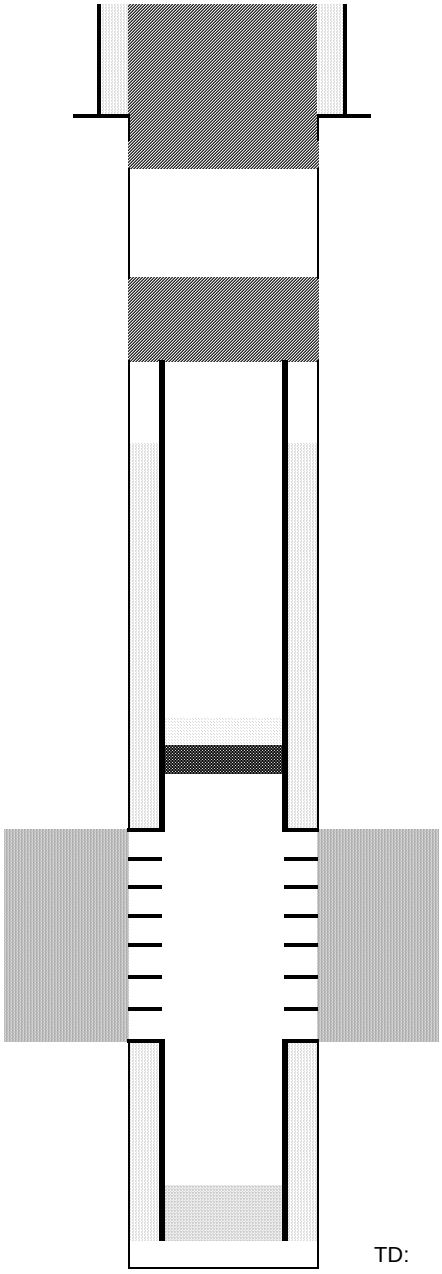

Cut surface casing off 6'-8' below surface.

Pump approx 400 sx shoe plug @ 1006'
Will bring cement to surface.

Cut and pull csg ~2500'
100 sx Stub Plug

CIBP @ 6756' w/ 2 sx cement on top

Niobrara Perforations: 6806' - 6906'

Codell Perforations: 7043' - 7055'

TD: 7195'