


After P&A Schematic:

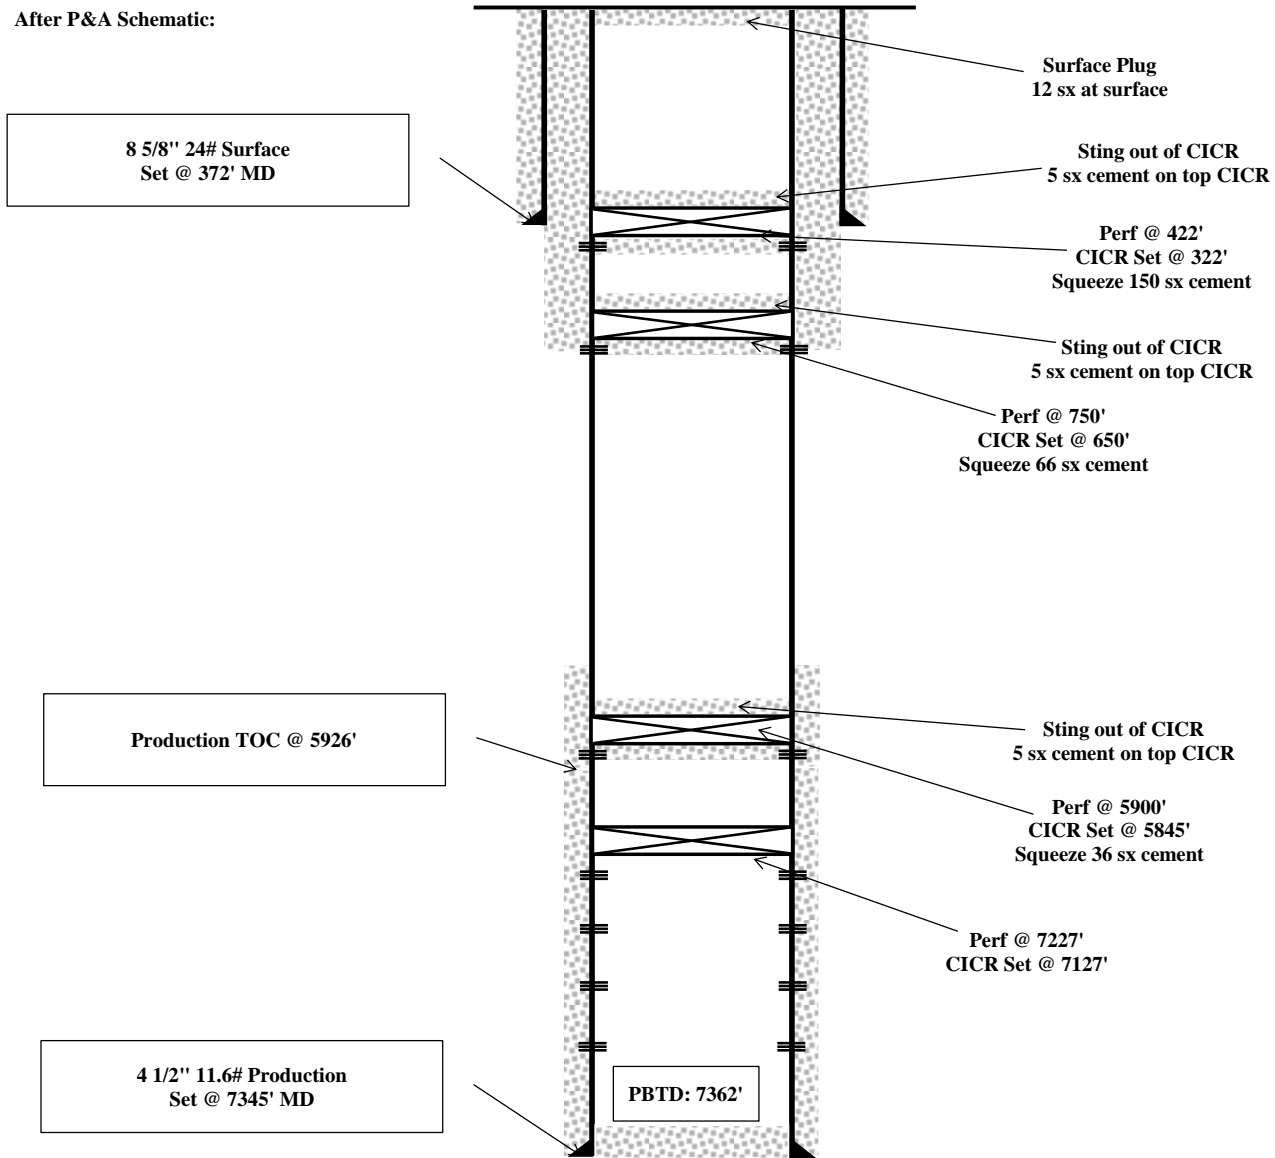

Zone	Perforation Data	
	Top (ft)	Bottom (ft)
	7227	7248