




BILL BARRETT CORPORATION
RECLAMATION DIAGRAM FOR
ANSCHUTZ STATE #5-61-36-0108BH
SECTION 36, T5N, R61W 6th P.M.
501' FNL 501' FWL

FIGURE #4

SCALE: 1" = 60'
DATE: 04-29-11
DRAWN BY: S.R.L.
REVISED: 08-16-12
REVISED: 08-22-13 J.S.
REVISED: 10-17-13 J.W.

Access Road

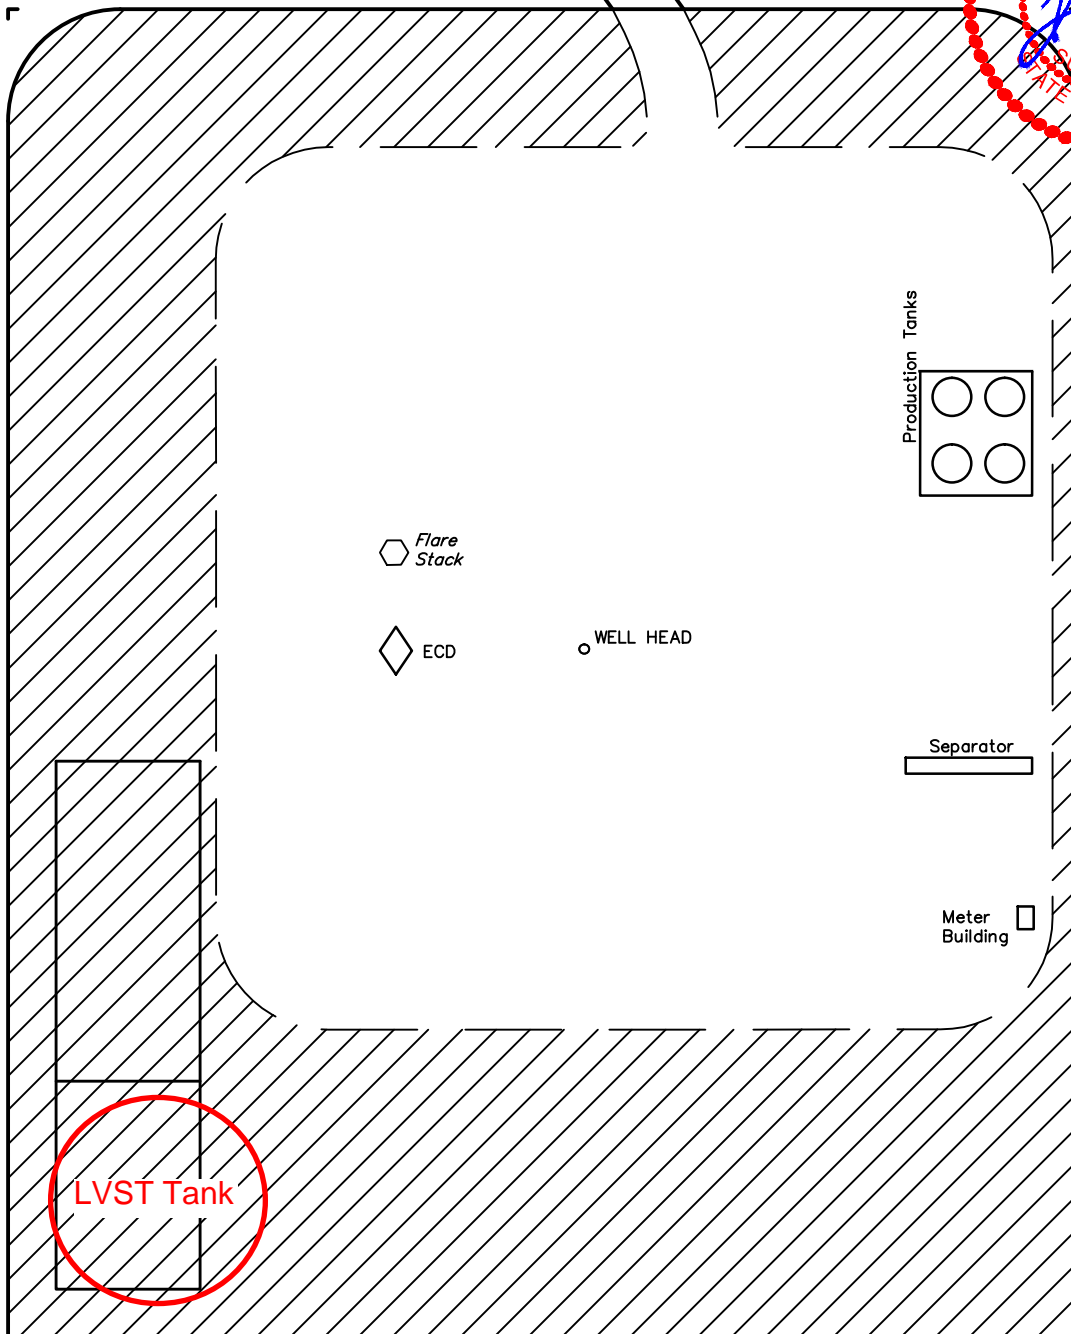

APPROXIMATE ACREAGES
UN-RECLAIMED = ± 1.653 ACRES



UINTAH ENGINEERING & LAND SURVEYING
85 So. 200 East * Vernal, Utah 84078 * (435) 789-1017