


WPX Energy Rocky Mountain LLC
FEDERAL RU 22-5
RULISON Field

SHL 250' FNL x 2612' FWL (SE/4 NW/4) Section: 5-T7S-R93W 6th PM
BHL 834' FSL x 1863' FWL (NE/4 SW/4) Section: 5-T7S-R93W 6th PM
Garfield County Colorado

Formation Tops
(Measured Depths)

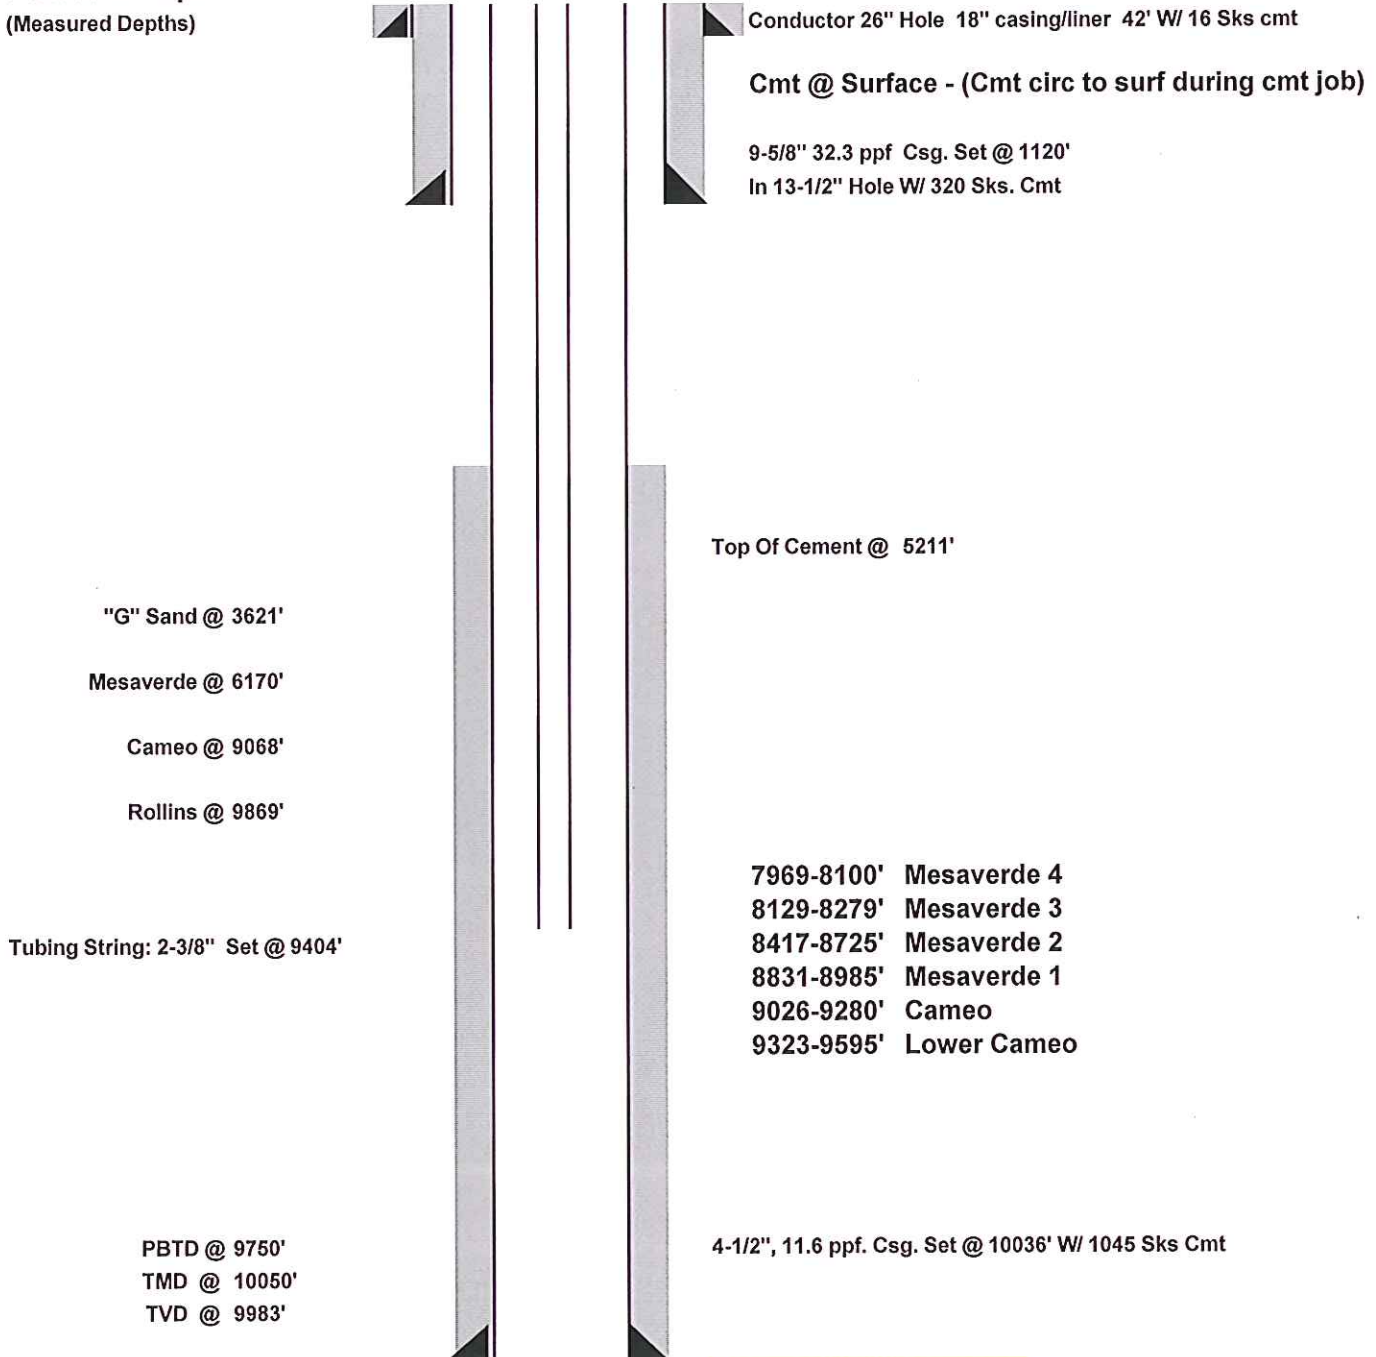

DATE CREATED: 12/17/2013

NOTE: THIS IS NOT TO SCALE.
FINAL