


**WPX Energy Rocky Mountain LLC
FEDERAL RU 332-5
RULISON Field**

**SHL 254' FNL 2624' FWL (SE/4 NW/4) Section 5 T7S R93W 6th PM
BHL 1256' FSL 2147' FEL (NW/4 SE/4) Section 5 T7S R93W 6th PM
Garfield County Colorado**

**Formation Tops
(Measured Depths)**

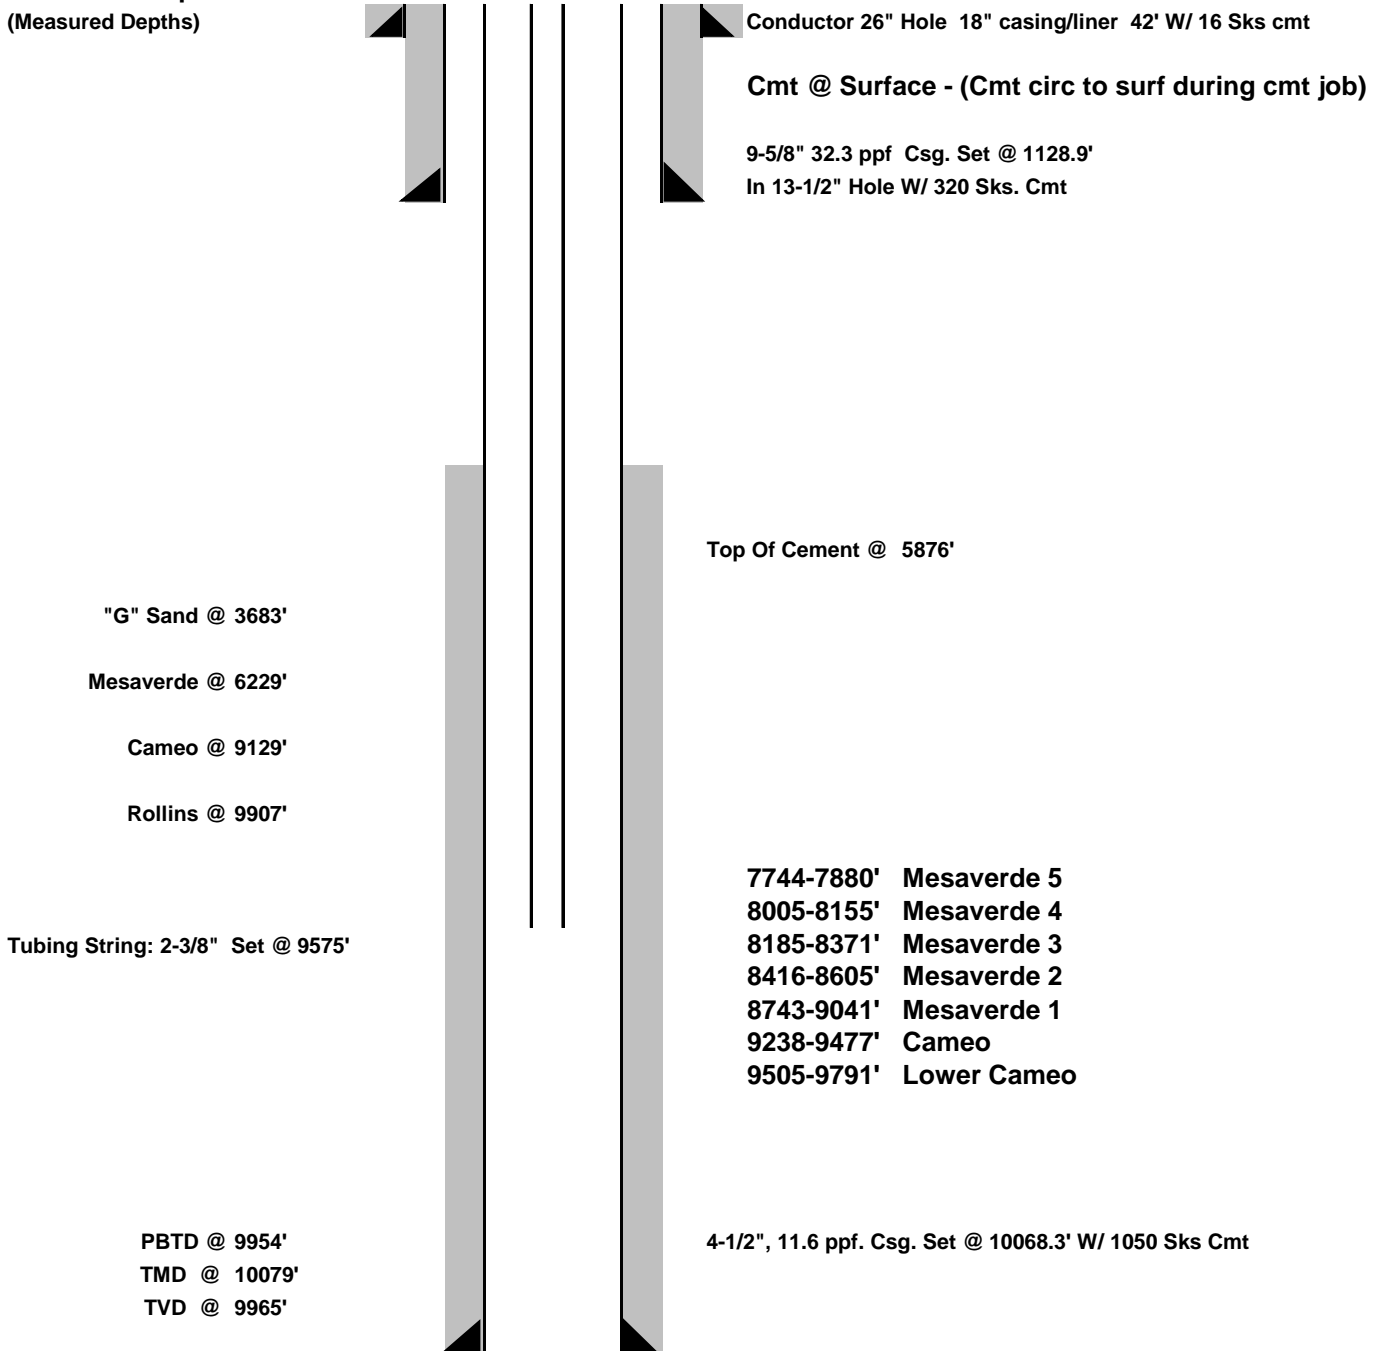

DATE CREATED: 12/17/2013

NOTE: THIS IS NOT TO SCALE.
****FINAL****