


KERR-MCGEE OIL AND GAS ONSHORE LP

**SCHLAGEL 14-4
SW SW 4 3N 67W -- --
WELD,COLORADO
12/30/2013**

AREA: N2 ROUTE: N22 Spud: 01/15/1994 WINS No.: 75712 AFE/WO#: 2088928 API#: 0512317873

GL: 4847 KB: 4857 MTD: 7305 TVD: 7305 LOG MD: PBMD: 7255 PBTVD: 7255

Directions: WCR 36 & WCR 17, N 1/10, E 1/10 INTO

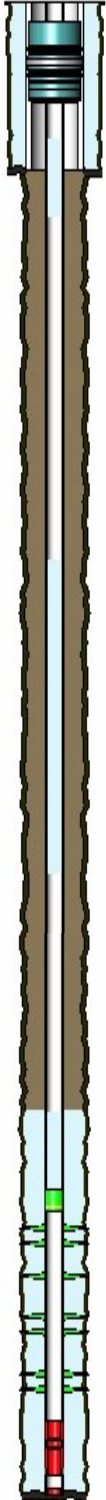

<u>HOLE SECTIONS</u>	<u>Size</u>	<u>Top</u>	<u>Btm</u>	<u>TD Date</u>				
SURFACE	12.25	10	539	01/15/1994				
PRODUCTION	7.88	539	7305	01/19/1994				
<u>TUBULARS</u>	<u>Tool Type</u>	<u>Joints</u>	<u>Size</u>	<u>Weight</u>	<u>Grade</u>	<u>Thread</u>	<u>Top D</u>	<u>Bottom D</u>
SURFACE CASING	Casing	12	8.63	24			10	529
PRODUCTION CASING	Casing	232	2.88	6.5	J-55	8RD EUE	10	7267
	Casing Float Collar	1	2.88				7267	7268
	Casing	1	2.88	6.5	J-55	8RD EUE	7268	7297
	Casing Guide Shoe	1	2.88				7297	7298
BRIDGE PLUG	Cast Iron Bridge Plu	1	2.83				6850	6851
BRIDGE PLUG	Bridge Plug	1	8.63				100	102
<u>CEMENT JOBS</u>	<u>Stage</u>	<u>Sacks</u>	<u>Cement Jobs</u>			<u>Top D</u>	<u>Btm D</u>	<u>cbl</u>
SURFACE CASING	STAGE 1	225		A		10	529	No
PRODUCTION CASING	STAGE 1	211		50/50 POZ-MIX		6356	7298	Yes
PRODUCTION CASING	ABANDONMENT PLUC	10	LEAD	FRESH WATER		6370	6840	No
PRODUCTION CASING	ABANDONMENT PLUC	575	LEAD	FRESH WATER		2950	4890	No
PRODUCTION CASING	ABANDONMENT PLUC	175	LEAD	FRESH WATER		532	825	No
PRODUCTION CASING	ABANDONMENT PLUC	50	LEAD	FRESH WATER		330	532	No
<u>PERFORATIONS</u>	<u>Formation</u>	<u>Zone</u>	<u>Top</u>	<u>Btm</u>	<u>Date</u>	<u>Reason</u>	<u>Comments</u>	
	NIOBRARA		6891	6905	07/15/1994	PRODUCTION		
	NIOBRARA		6951	6964	07/15/1994	PRODUCTION		
	NIOBRARA		7041	7054	07/15/1994	PRODUCTION		
	CODELL		7167	7177	02/07/1994	PRODUCTION		

Comments: