

# NOBLE ENERGY INC.

STEPHENS 01  
SWNW 15-4N-66W

Weld County, Colorado  
Wattenberg  
CURRENT WELLBORE SCHEMATIC  
with PROPOSED P&A  
12/30/2013



API: 05-123-11552  
COGCC #

GL Elev: 4732  
KB Elev: 0

Spud Date:

Surface Casing :  
8 5/8" 24# @ 406'  
Cement: 300 sx  
TOC: Surface

Cmt 2000'-3000'

Cut surface casing off 6'-8' below surface.

Pump approx 475 sx shoe plug @ 600'  
Will bring cement to surface.


TOC @ 6188'

Perforate @ 5000'  
100 sx plug

CIBP @ 7185 w/ 2 sx cement on top

Production Casing :  
5 1/2" 20# @ 7850'  
Cement: 225 sx  
TD: #REF!

Codell Perfs 7235' - 7243'

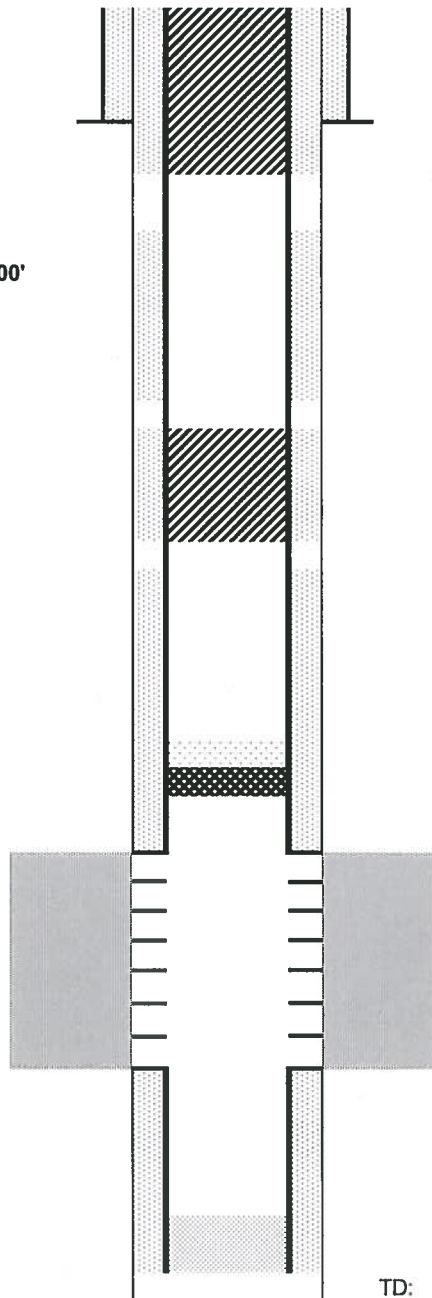

TD: 7850