

Physical Address: 345 Comanche St.
Mail to: Box 384, Kiowa, CO 80117
Ph. 303-621-8672 - Fax 303-621-7749
www.highprairiesurvey.com


Job # 13171 Big Wampum #4

Inv # 2878

High Prairie Surveying of Kiowa, Colorado, in accordance with a request from **Wiepking Fullerton**, has determined the location of **Big Wampum #4** to be **1980 feet FNL**, and **1980 feet FEL**, (90° off Section lines) of **SECTION 23**, Township **10s**, Range **56w** of the 6th Principal Meridian, **Lincoln County**, Colorado.

Date: Staked on 12/16/2013 drawn on 12/23/2013.

Re: Staked by Elijah Frane
Drawn: Drawn by Dustin Cotter

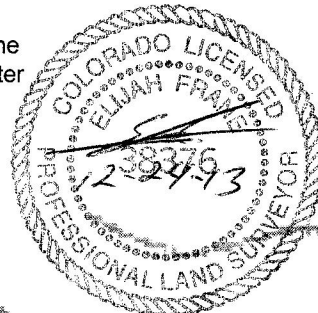

Location Drawing

There is a barb wire fence approximately 173' Northeast of the proposed well pad at its closest point.

Wiepking Fullerton
NE 1/4 Sec. 23-10s-56w
Big Wampum #4
Lincoln, County, Colorado

