


KERR-MCGEE OIL AND GAS ONSHORE LP
SHAW FLOYD C UNIT 1
SW SW 1 2N 67W 990' FSL 1,140' FWL
WELD,COLORADO
01/02/2014

AREA: S1 ROUTE: S12 Spud: 07/07/1973 WINS No.: 74766 AFE/WO#: 2090553 API#: 0512307741

GL: 4831 KB: 4841 MTD: 7964 TVD: 7964 LOG MD: 7961 PBMD: 7906 PBTVD: 7906

Directions: WCR 24-1/2 & WCR 23, S 2/10, E 2/10 INTO

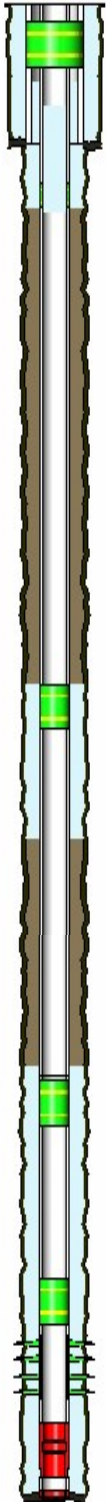

<u>HOLE SECTIONS</u>	<u>Size</u>	<u>Top</u>	<u>Btm</u>	<u>TD Date</u>
SURFACE	12.25	10	638	07/08/1973
PRODUCTION	7.88	638	7964	07/25/1973

<u>TUBULARS</u>	<u>Tool Type</u>	<u>Joints</u>	<u>Size</u>	<u>Weight</u>	<u>Grade</u>	<u>Thread</u>	<u>Top D</u>	<u>Bottom D</u>
SURFACE CASING	Casing	14	8.63	23.00	H-40		10	632
PRODUCTION CASING	Casing	3	4.50	11.60	K-55	STC	10	109
	Casing	28	4.50	10.50	K-55	STC	109	910
	Cement Stage Too	1	4.50				910	912
	Casing	176	4.50	10.50	K-55	STC	912	6623
	Casing	40	4.50	11.60	K-55	STC	6623	7924
	Float Collar	1	4.50				7924	7925
	Casing	1	4.50	11.60	K-55	STC	7925	7958
	Casing Shoe	1	4.50				7958	7960
BRIDGE PLUG	Cast Iron Bridge Plu	1	4.50				7720	7722
BRIDGE PLUG	Cement Retainer	1	4.50				6660	6662
BRIDGE PLUG	Cement Retainer	1	4.50				4220	4222
BRIDGE PLUG	Cast Iron Bridge Plu	1	8.63				100	103

<u>CEMENT JOBS</u>	<u>Stage</u>	<u>Sacks</u>	<u>Cement Jobs</u>	<u>Top D</u>	<u>Btm D</u>	<u>cbl</u>
SURFACE CASING	STAGE 1 LEAD	300	50/50 POZMIX	10	400	No
	STAGE 1 TAIL	200	REGULAR	400	632	No
PRODUCTION CASING	STAGE 2	200	50/50 POZMIX	200	912	No
	STAGE 1	200	50/50 POZMIX	7000	7960	No
PRODUCTION CASING	ABANDONMENT PLUC	140	LEAD FRESH WATER	6550	7170	No
PRODUCTION CASING	ABANDONMENT PLUC	780	LEAD FRESH WATER	4110	4980	No
PRODUCTION CASING	ABANDONMENT PLUC			376	950	No

<u>PERFORATIONS</u>	<u>Formation</u>	<u>Zone</u>	<u>Top</u>	<u>Btm</u>	<u>Date</u>	<u>Reason</u>	<u>Comments</u>
	SUSSEX		4210	4211	11/07/2013	CEMENT SQUEEZE	
	SUSSEX		4980	4981	11/07/2013	CEMENT SQUEEZE	
	NIOBRARA		6650	6651	11/06/2013	CEMENT SQUEEZE	
	NIOBRARA		7170	7171	11/06/2013	CEMENT SQUEEZE	
	J SAND		7786	7800	11/23/1973		
	J SAND		7812	7840	11/23/1973		

Comments: