

WPX Energy Rocky Mountain LLC

WPX ENERGY RWF 42-4


RULISON Field

SHL 415' FNL 1674' FEL (NW/4 NE/4) LOT 2 Section 4 T7S R94W 6th PM

BHL 1171' FNL 1318' FEL (NW/4 NE/4) LOT 2 Section 4 T7S R94W 6th PM

Garfield County Colorado

Formation Tops
(Measured Depths)

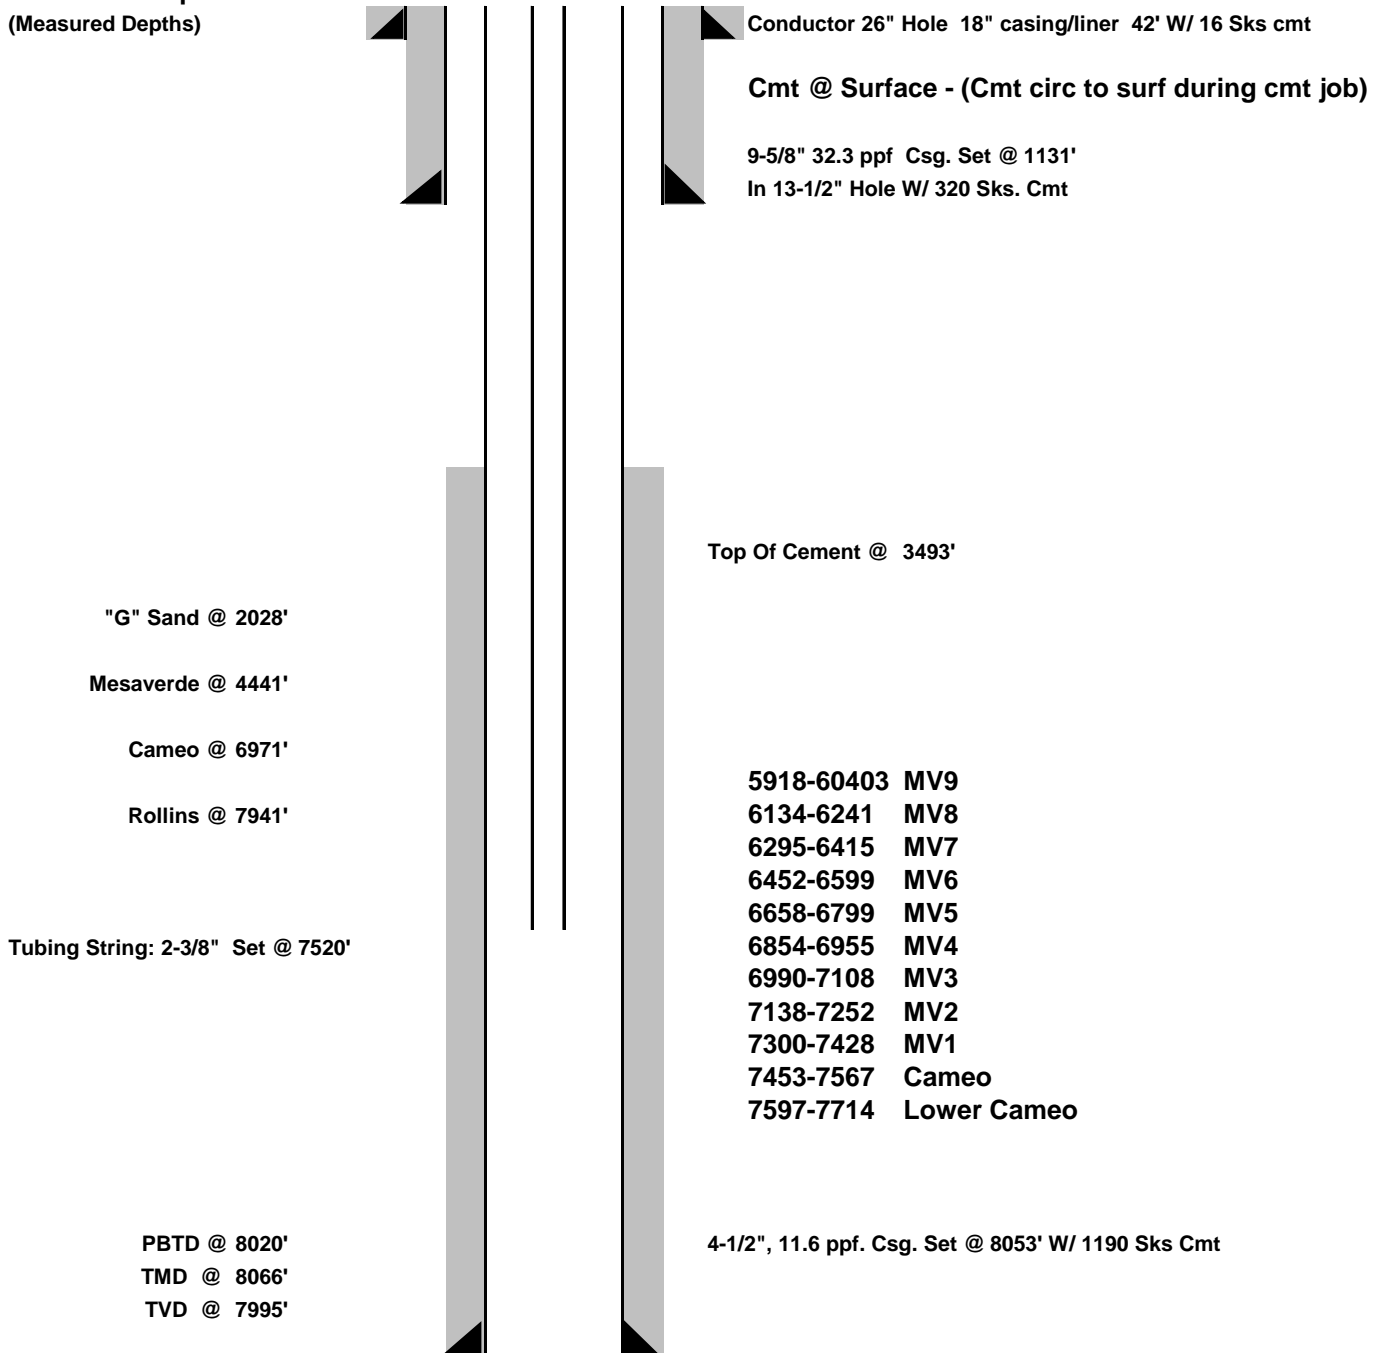

DATE CREATED: 1/6/2014

NOTE: THIS IS NOT TO SCALE.
****FINAL****