



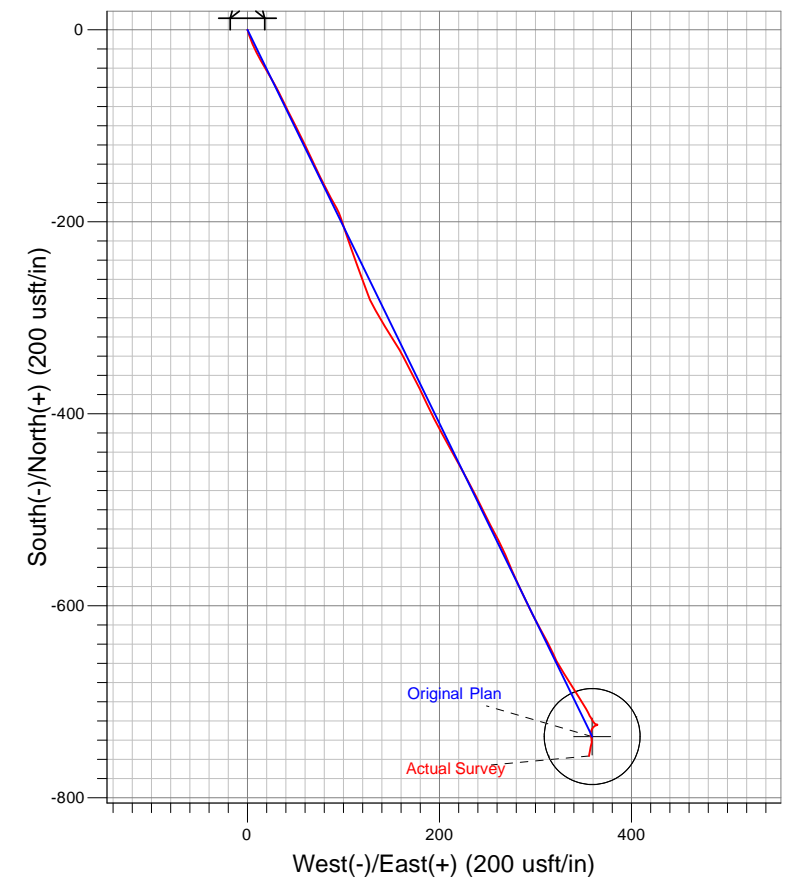

Well Name: RWF 42-4  
Surface Location: RMV 108-4 Pad  
North American Datum 1983 , US State Plane 1983 . Colorado Central Zone  
Ground Elevation: 5794.00

+N/-S	+E/-W	Northing	Easting	Latitude	Longitude	Slot
0.00	0.00	1606157.00	2325705.40	39.47333	-107.88892	A03

KELLY BUSHING @ 5820.00usft (Nabors 574 (26' RKB) kjs)

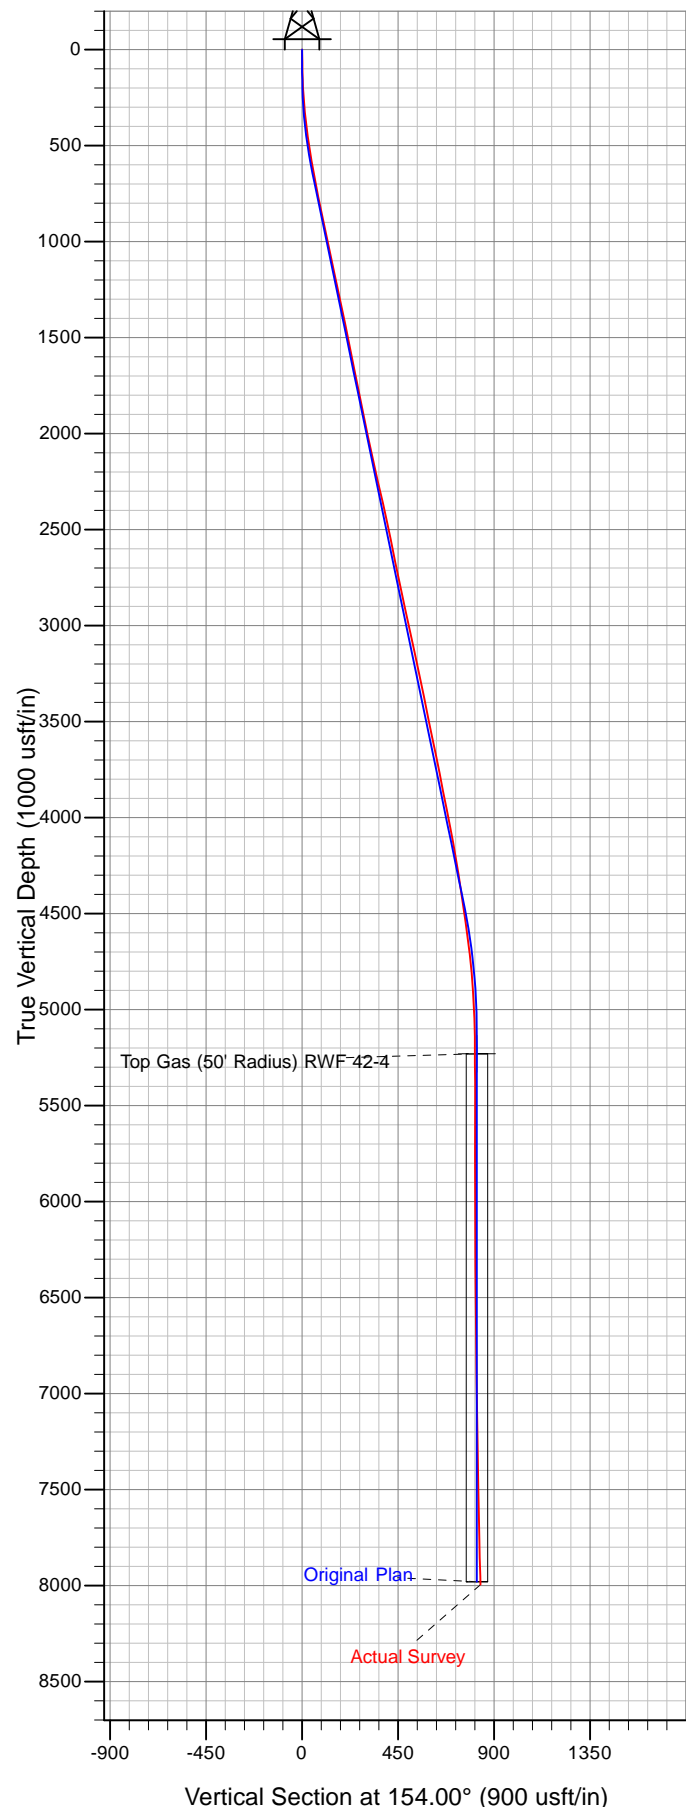

T  
M

Azimuths to True North  
Magnetic North: 10.01°

Magnetic Field  
Strength: 52020.7snT  
Dip Angle: 65.68°  
Date: 10/3/2013  
Model: IGRF2010