


WPX Energy Rocky Mountain LLC  
FEDERAL RU 43-5  
RULISON Field

SHL 247' FNL 2622' FWL (SE/4 NW/4) Section 5 T7S R93W 6th PM  
BHL 1277' FSL 770' FEL (NE/4 SE/4) Section 2 T7S R95W 6th PM  
Garfield County Colorado

Formation Tops  
(Measured Depths)

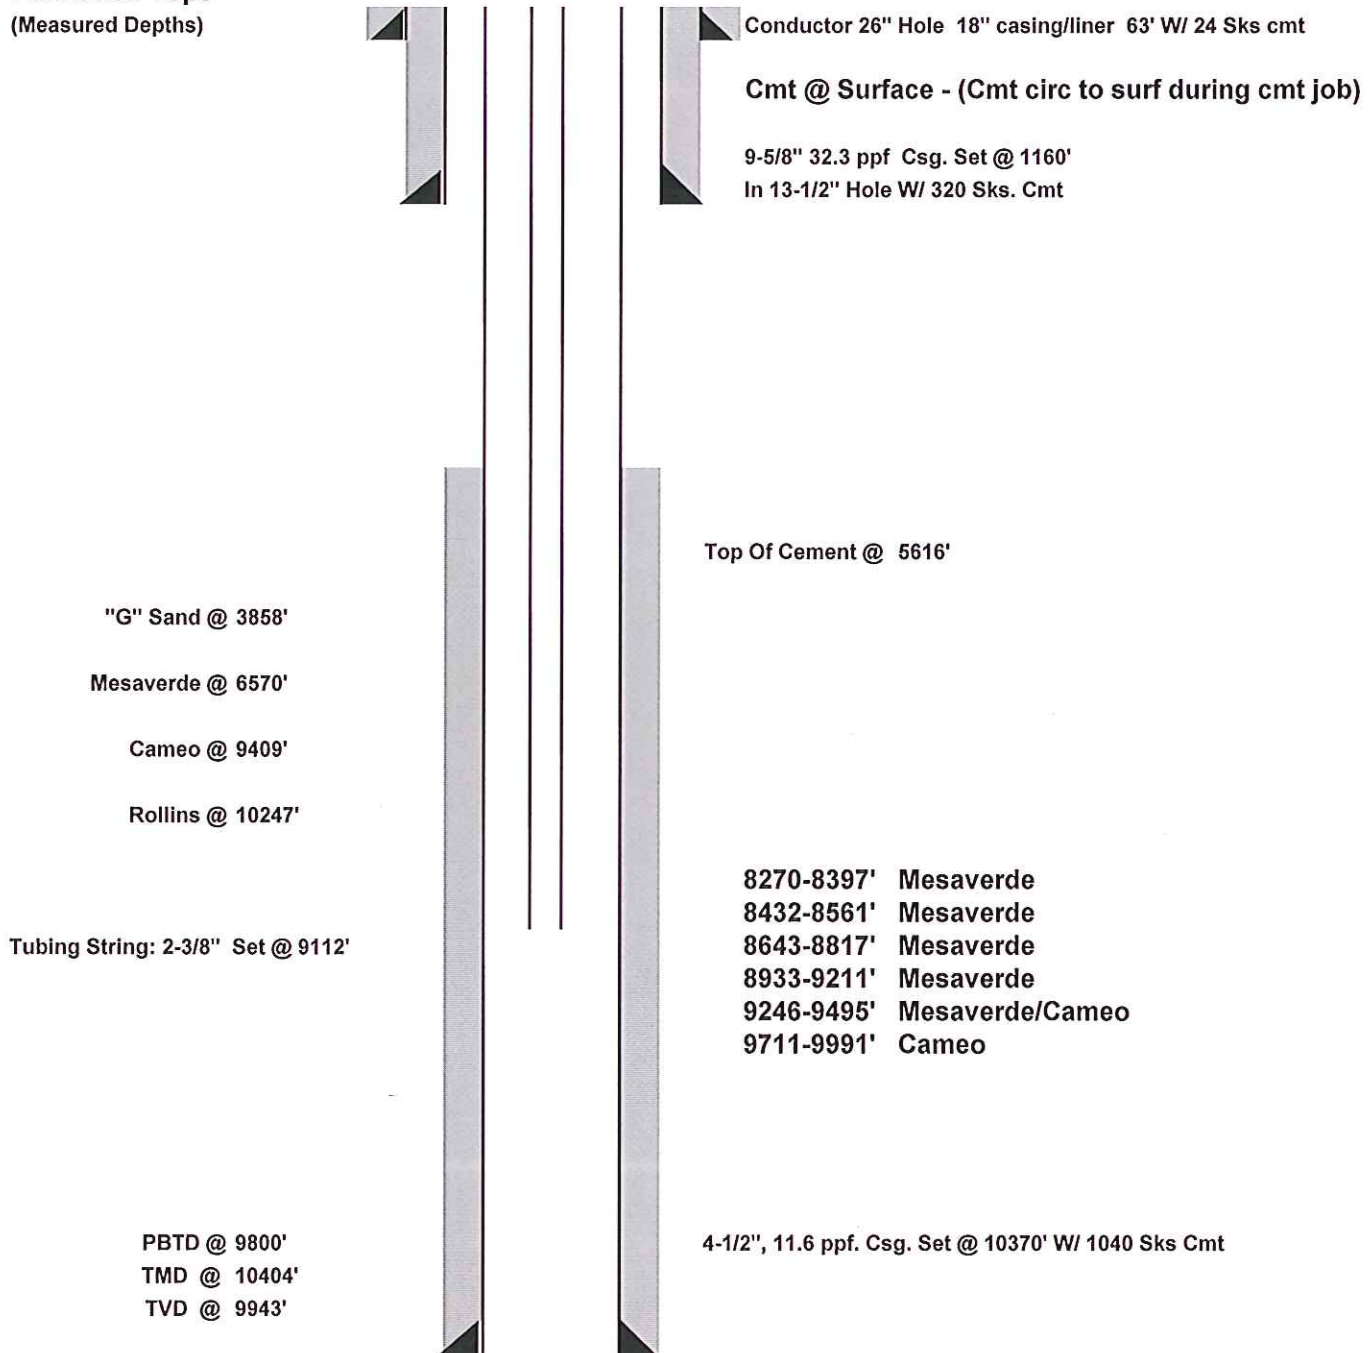

DATE CREATED: 12/18/2013

NOTE: THIS IS NOT TO SCALE.  
\*\*FINAL\*\*