




Job ID : GW CAMPBELL 17-41D
Company : GREAT WESTERN
Lease/Well : CAMPBELL 17-41D / JF 17-9D
Location : SEC.17-T2N-R65W
API JOB # : TBA
Rig Name : CADE 25
State/Province : COLORADO
County/Parish : WELD
Country : USA


Latitude : 40°8'30.5088" N
Longitude : -104°41'1.4892" W
Northing : 1295554.47
Easting : 3228194.76
System Zone : US State Plane 1983
Projection Type : LAMBERT
ELEVATION : 4,916'
RKB : 14 ft
Comment : Actual



Vertical Section Plot

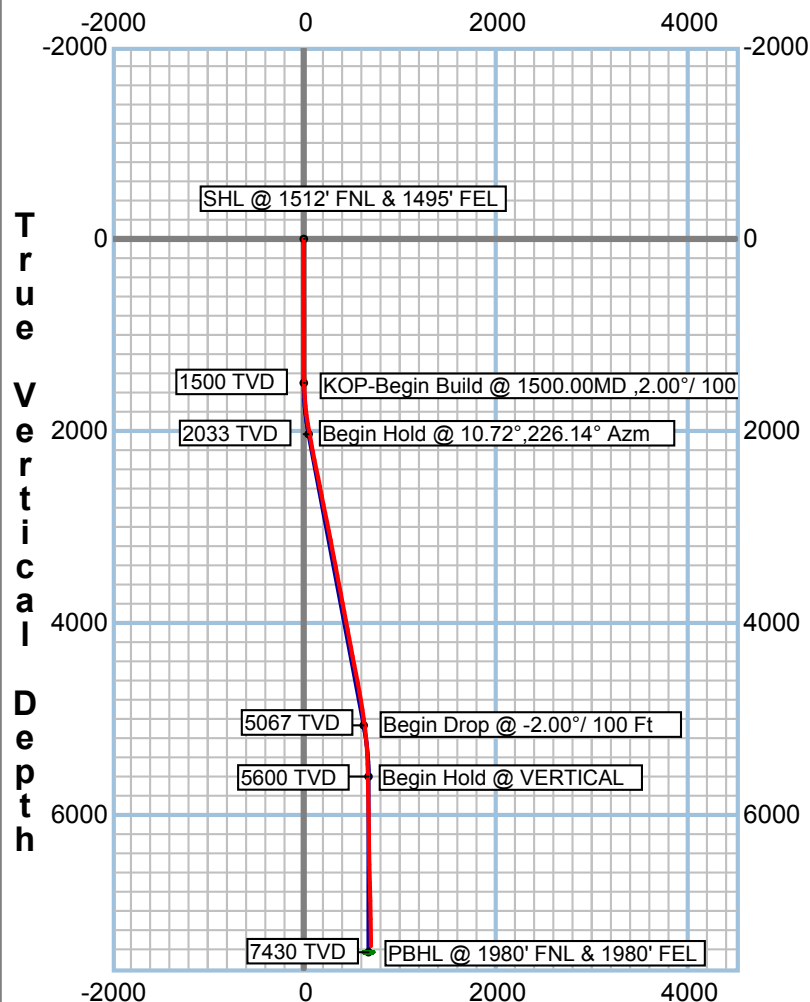

Horizontal Plot

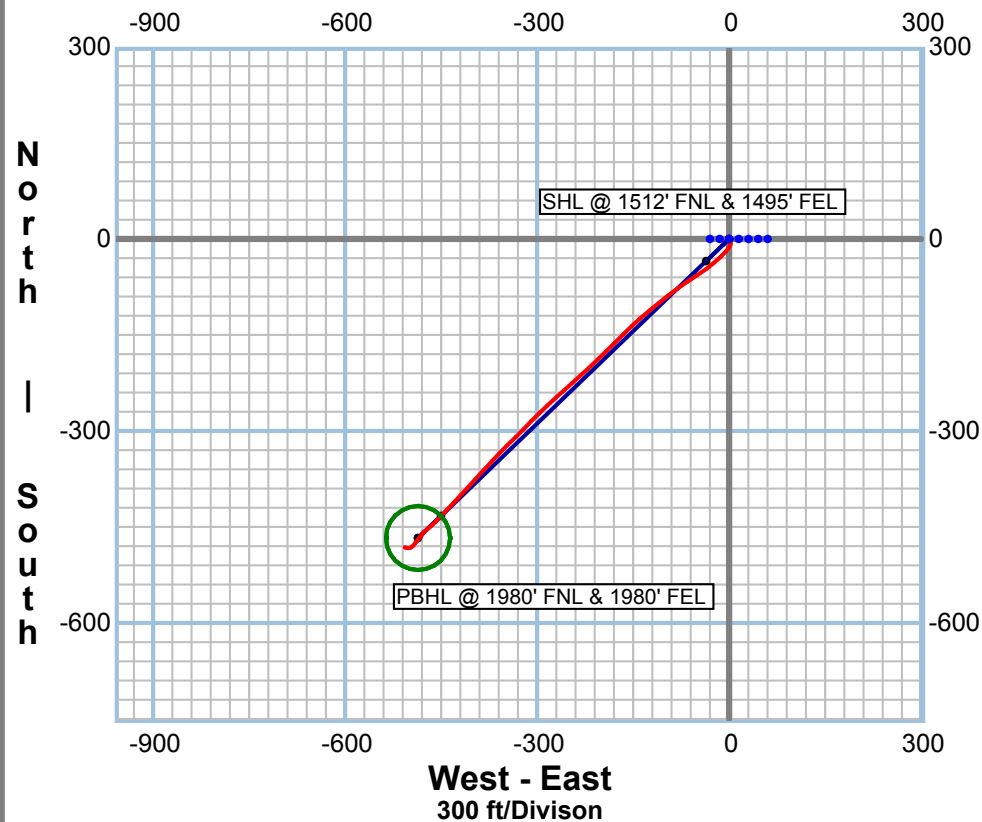

CRITICAL POINTS - GW CAMPBELL 17-9D PROPOSAL

MD	Inc	Azm	TVD	EW	NS	VS	CI	Cldir	WR	BR	DLS
0.00	0.00	0.00	0.00	0.00	0.00	0.00	0.00	0.00	0.00	0.00	0.00
1500.00	0.00	0.00	1500.00	0.00	0.00	0.00	0.00	0.05	0.00	0.00	0.00
2035.95	10.72	226.14	2032.83	-36.04	-34.63	49.99	49.99	226.14	0.00	2.01	2.01
5124.18	10.72	226.14	5067.16	-450.23	-432.66	624.43	624.43	226.14	0.00	0.00	0.00
5660.28	0.00	0.00	5600.14	-486.28	-467.31	674.42	674.42	226.14	833.05	-1.99	1.99
7490.14	0.00	0.00	7430.00	-486.28	-467.31	674.42	674.42	226.14	0.00	0.00	0.00