

WPX Energy Rocky Mountain LLC

Federal PA 514-12

Parachute Field


SHL 2582' FSL 1754' FWL (NE/4 NW/4) Section 12 T7S R95W 6th PM

BHL 203' FSL 583' FWL (SW/4 SW/4) Section 12 T7S R95W 6th PM

Garfield County Colorado

Formation Tops

(Measured Depths)

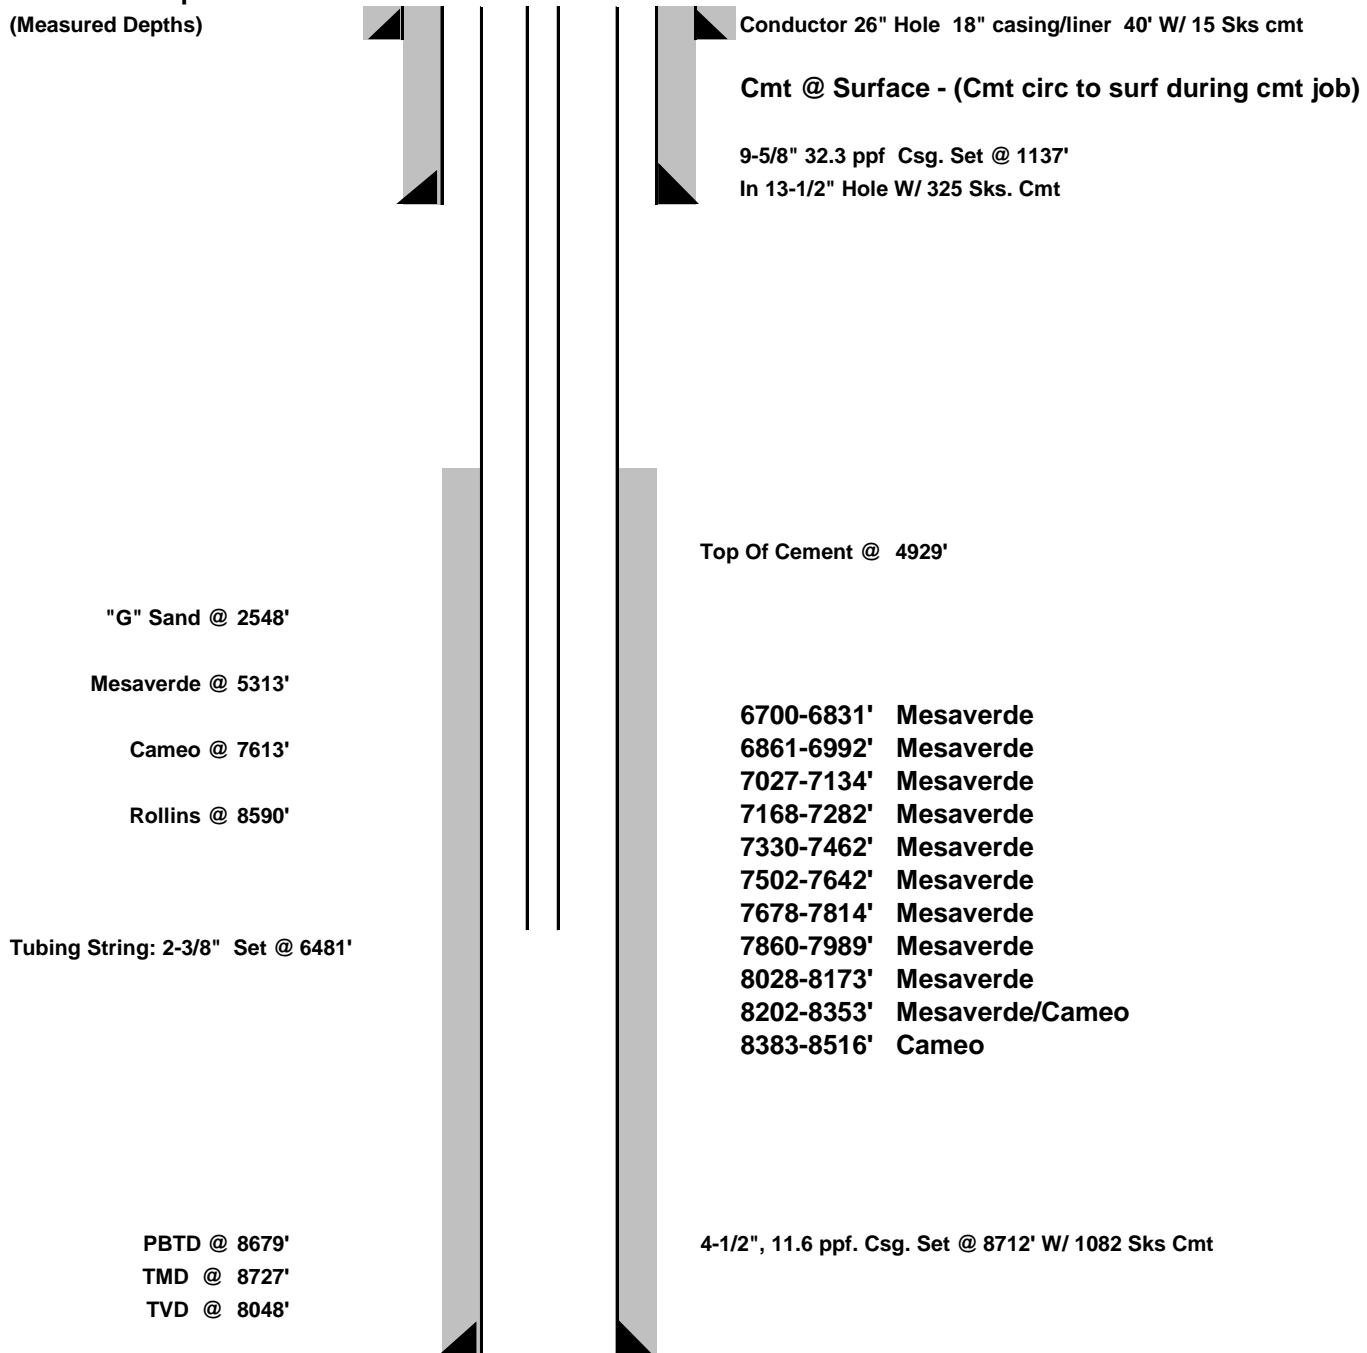

DATE CREATED: 1/6/2014

NOTE: THIS IS NOT TO SCALE.

FINAL