


WPX ENERGY ROCKY MOUNTAIN, LLC
FEDERAL RU 331-5
MAMM CREEK Field
SHL 225' FNL 2615' FWL (LOT 2) BHL 509' FNL 1974' FEL
Section 5-T7S-R93W 6th PM
Garfield County, Colorado

Formation Tops
(Measured Depths)

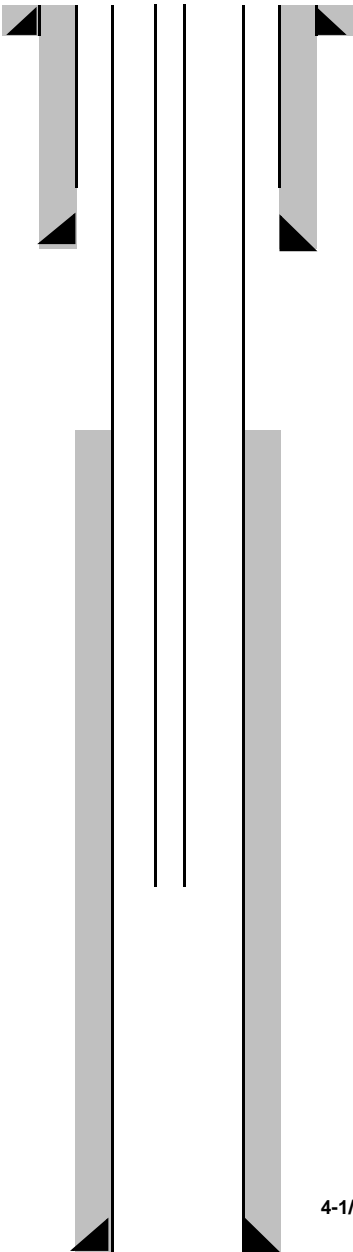

Cmt @ Surface - (Cmt circ to surf during cmt job)

9 5/8" 32.3# ppf Csg. Set @1147'
In 12 1/4" Hole W/320 Sks. Cmt

Top Of Cement @ 4480'

PBTD @
TMD @ 10030'
TVD @ 9987'

4-1/2", 11.6 ppf. Csg. Set @10015' W/1035 sks Cmt