

**WPX Energy Rocky Mountain LLC**

**FEDERAL PA 431-21**

**Parachute Field**


**SHL 2600' FNL 1426' FWL (SE/4 NW/4) Section 21 T6S R95W 6th PM**

**BHL 907' FNL 1647' FEL (NW/4 NE/4) Section 21 T6S R95W 6th PM**

**Garfield County Colorado**

**Formation Tops**

(Measured Depths)

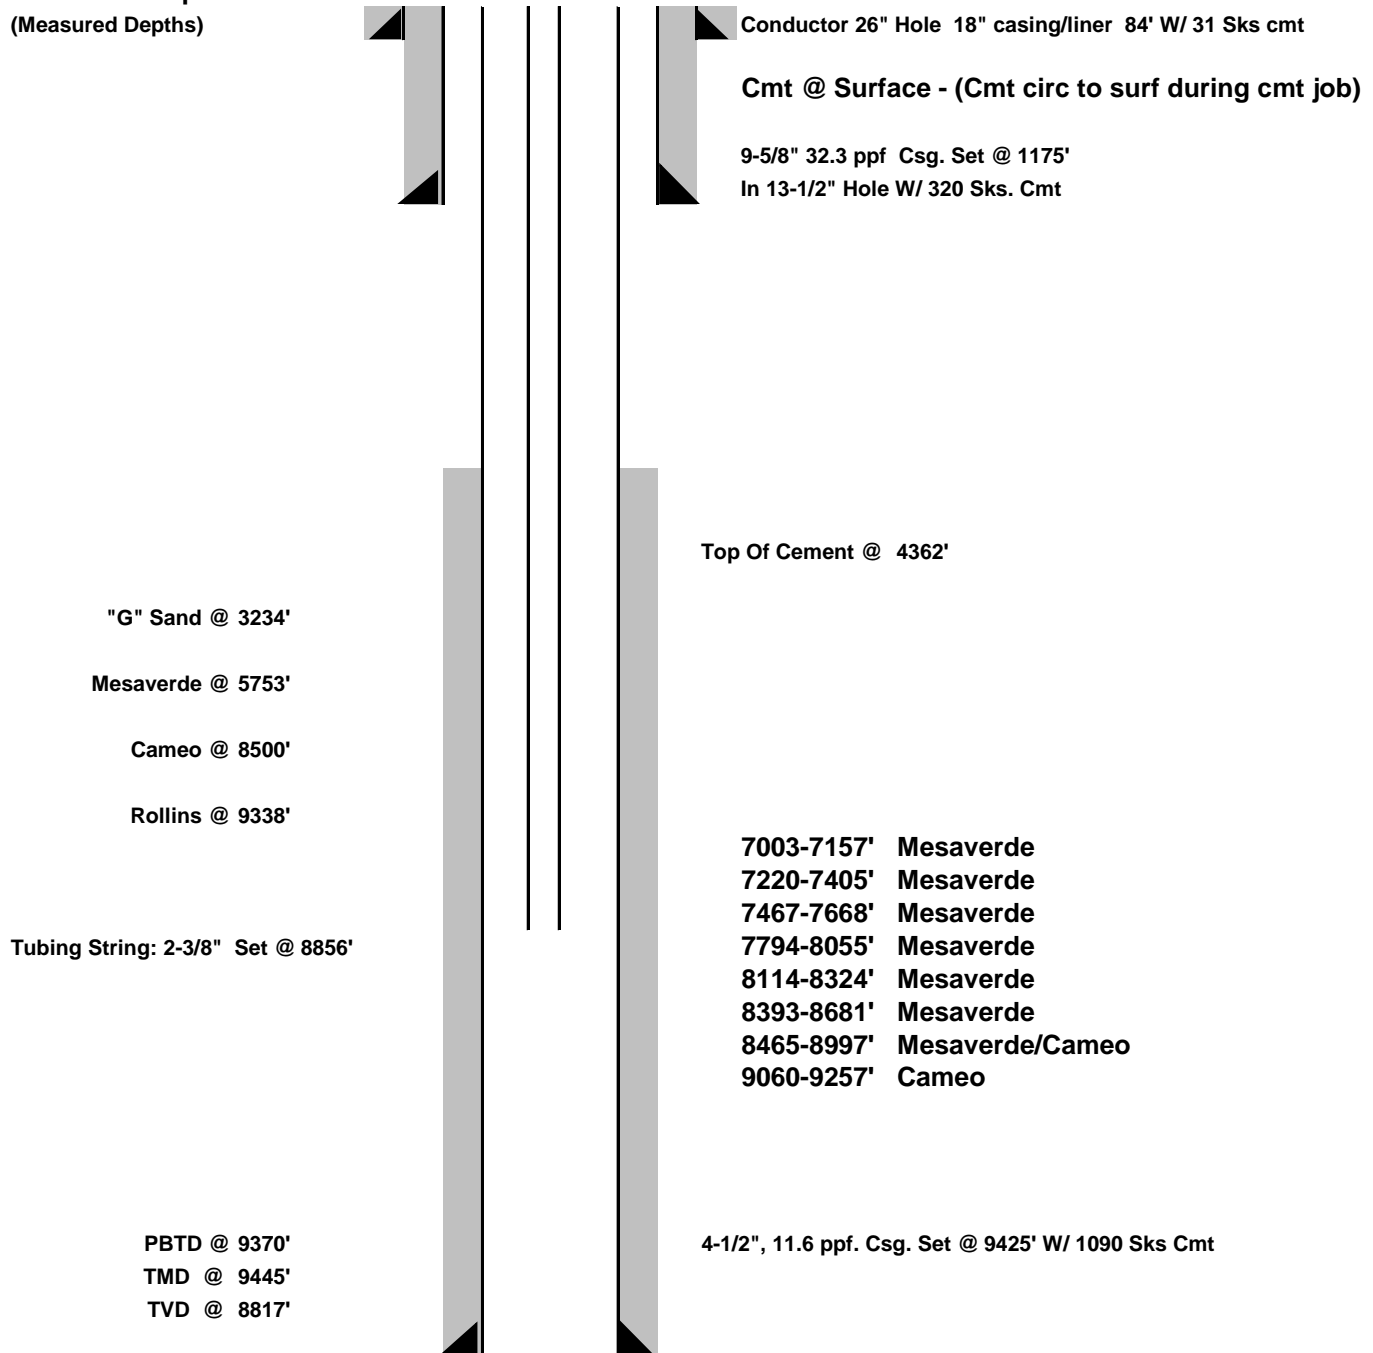

**DATE CREATED: 1/7/2014**

**NOTE: THIS IS NOT TO SCALE.**

**\*\*FINAL\*\***