


**WPX Energy Rocky Mountain LLC
FEDERAL PA 531-21
Parachute Field**

**SHL 2610' FNL 1426' FWL (SE/4 NW/4) Section 21 T6 R95W 6th PM
BHL 1236' FNL 1664' FEL (NW/4 NE/4) Section 21 T6S R95W 6th PM
Garfield County Colorado**

**Formation Tops
(Measured Depths)**

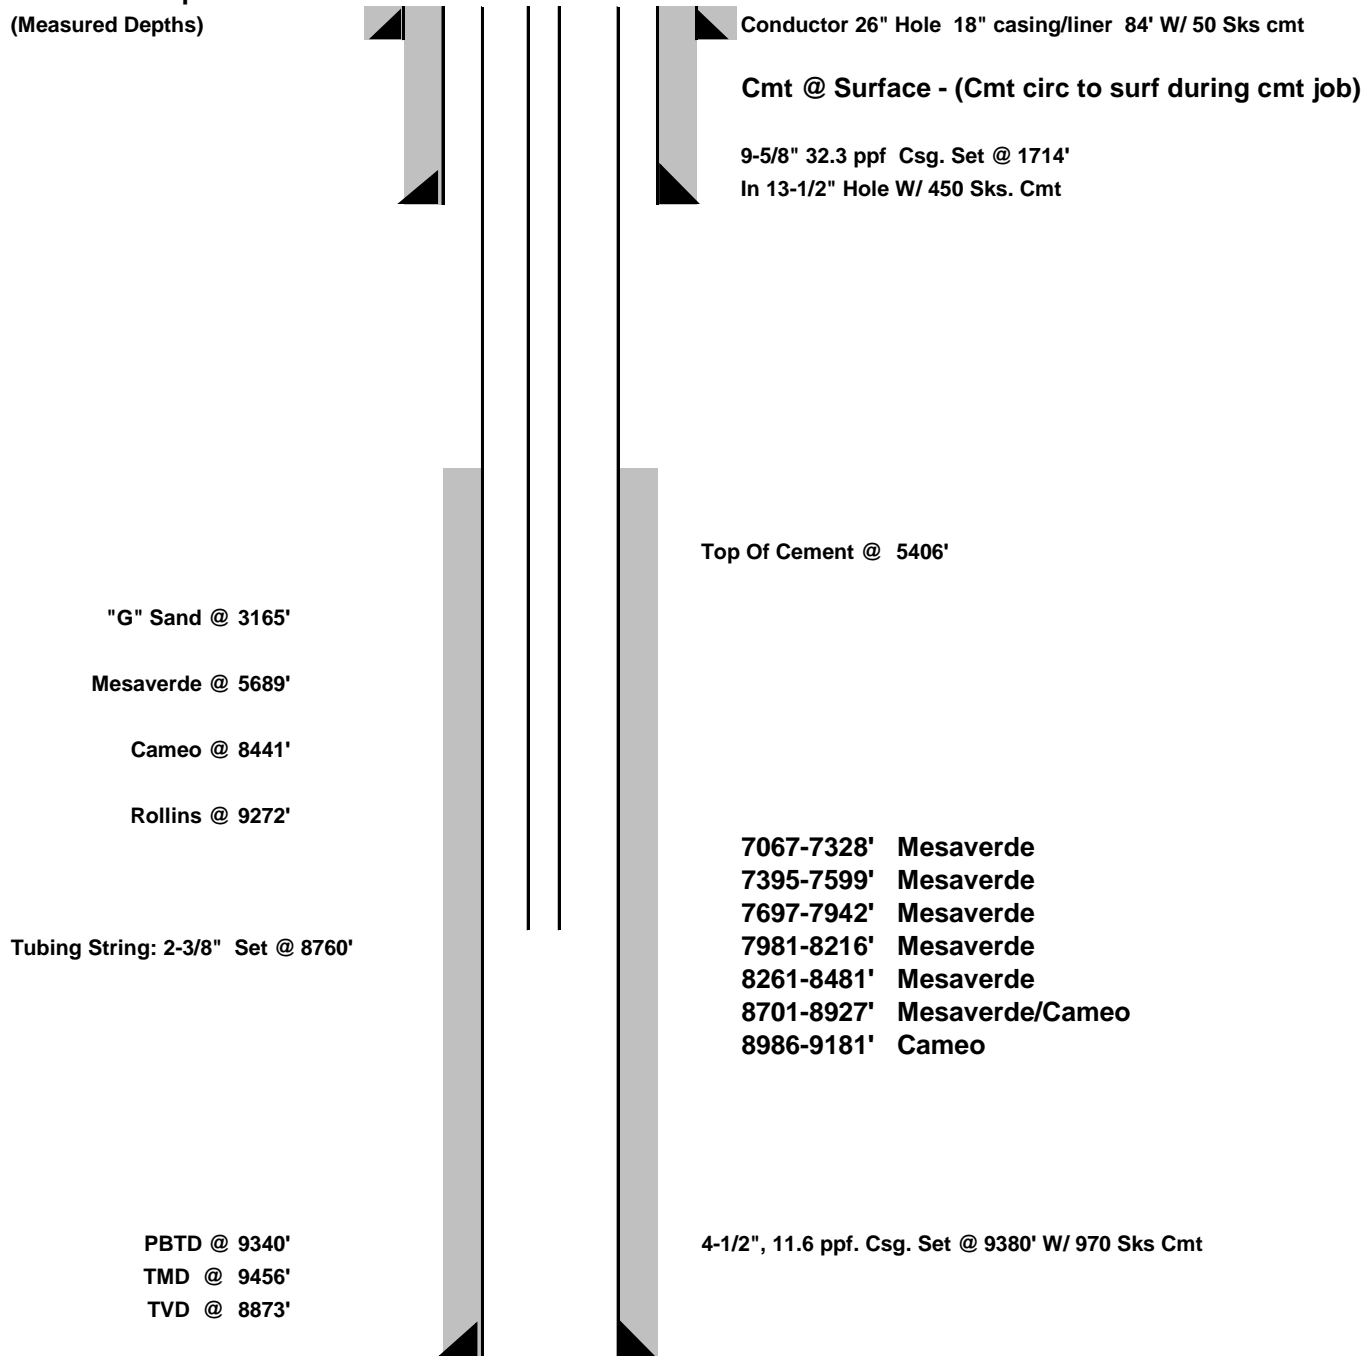

DATE CREATED: 1/7/2014

NOTE: THIS IS NOT TO SCALE.
****FINAL****