


WELLBORE DIAGRAM

Bayswater E & P
Larson Farms 4-24
NESW Sec 24-T6N-R64W
SHL: 2235' FSL, 2470' FWL
BHL: 1987' FSL, 648' FEL
Weld County CO
05-123-34148

Updated
10/23/2013
JRR

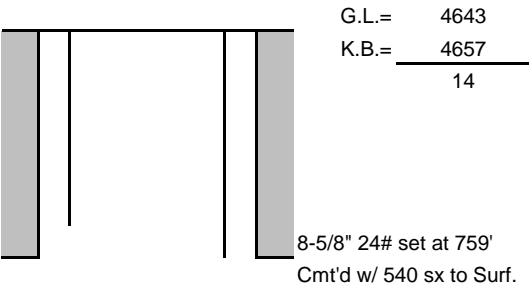

TOC: 1070'
CBL

