



Physical Address: 345 Comanche St.
Mail to: Box 384, Kiowa, CO 80117
Ph. 303-621-8672 - Fax 303-621-7749
www.highprairiesurvey.com

Job # 12111 Pepper #1

Inv # 2593

High Prairie Surveying of Kiowa, Colorado, in accordance with a request from **PRONGHORN OPERATING LLC**, has determined the location of **PEPPER #1** to be **1691 feet FNL**, and **2034 feet FEL**, (90° off Section lines) of **SECTION 5**, Township **14s**, Range **44w** of the 6th Principal Meridian, **Cheyenne County**, Colorado.

Date: Staked on 07/25/13 drawn on 07/31/13.

Rev: 08/12/13


Rev: 12/20/13

Re:

Staked by Elijah Frane

Drawn:


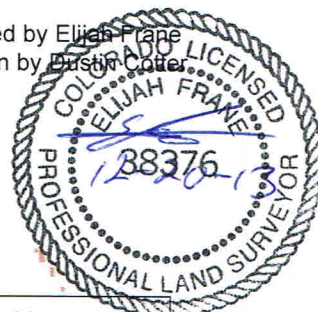

Location Drawing

There is a capped well 100' Northeast, and oil road approx. 78' East of the proposed well head at its closest point. There is oil road approx. 352' South, a power pole approx. 151' South and a power pole and overhead power line approx. 366' South of the proposed well pad at its closest point.

PRONGHORN OPERATING LLC
NE 1/4 SEC. 5-14S-44W
PEPPER #1
CHEYENNE, Co. COLORADO

UPRR-ROTH#3
CAPPED WELL

