




Lat40°, Inc. 1635 Foxtrail Drive, Suite 325 Loveland, CO 970-776-3321

# WELL LOCATION CERTIFICATE

THIS MAP DOES NOT REPRESENT A BOUNDARY SURVEY

SECTION: 4  
TOWNSHIP: 6N  
RANGE: 63W

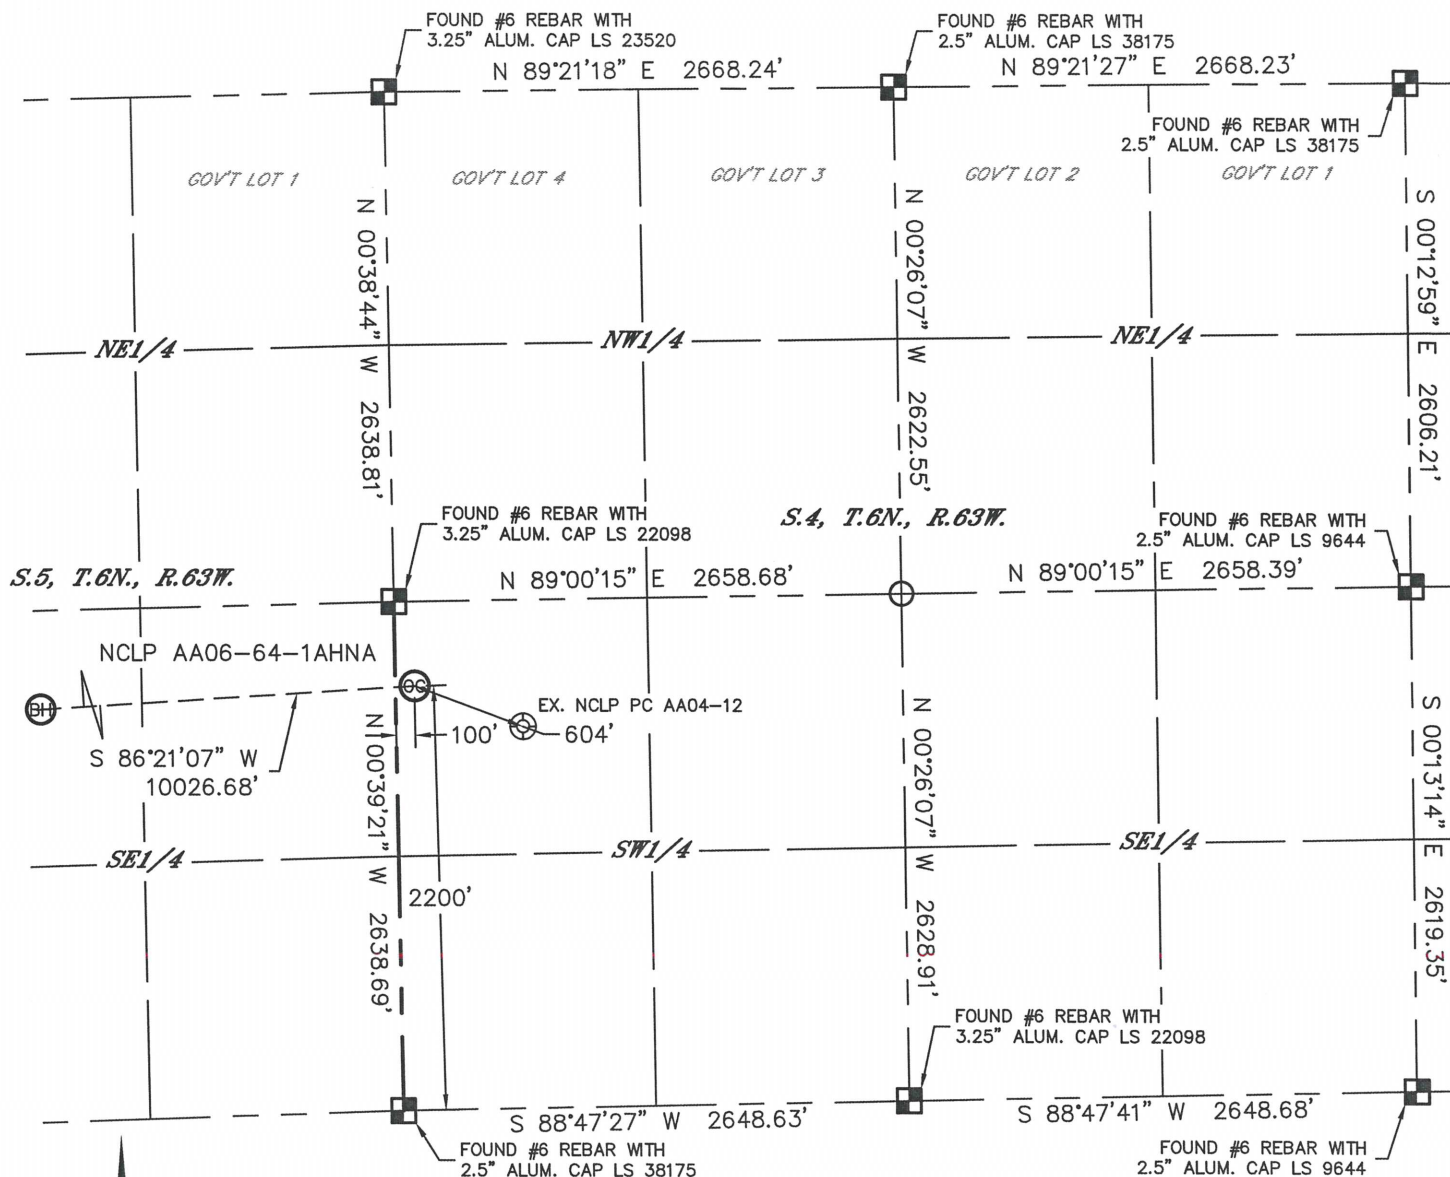

In accordance with a request from Greg Wilson with Noble Energy Inc. Lat40°, Inc. has determined the surface location of the NCLP AA06-64-1AHNA to be 2200' from the SOUTH line and 100' from the WEST line as measured at right angles from the section lines of Section 4, Township 6 North, Range 63 West and the bottom hole to be 1850' from the SOUTH line and 535' from the WEST line as measured at right angles from the section lines of Section 6, Township 6 North, Range 63 West of the Sixth Principal Meridian, County of Weld, State of Colorado.

I hereby state that this Well Location Certificate was prepared by me, or under my direct supervision, that the fieldwork was completed on 7/11/2013, for and on behalf of Noble Energy Inc. That this is not a Land Survey Plat or an Improvement Survey Plat, and that it is not to be relied upon for establishment of fence, building, or other future improvement lines.

#### NOTE:

- 1) Bearings shown are Grid Bearings of the Colorado State Plane Coordinate System, North Zone, North American Datum 1983/2007. The lineal dimensions as contained herein are based upon the "U.S. Survey Foot."
- 2) Ground elevations are based on an observed GPS elevation (NAVD 1988 DATUM).
- 3) IMPROVEMENTS: See LOCATION DRAWING for all visible improvements within 500' of disturbed area.
- 4) SURFACE USE: CROPLAND
- 5) INSTRUMENT OPERATOR: ADAM KELLY
- 6) NEAREST EXISTING WELL: NCLP PC AA04-12, 604'
- NEAREST CULTURAL ITEMS:  
BUILDING: ±3435' NW  
BUILDING UNIT: ±3435' NW  
HIGH OCCUPANCY BUILDING UNIT: 1001'+  
DESIGNATED OUTSIDE ACTIVITY AREA: 1001'+  
PUBLIC ROAD: COUNTY ROAD 74, 3068' N  
ABOVEGROUND UTILITY: 3044' N  
RAILROAD: 5280'+  
PROPERTY LINE: 438' N

#### SURFACE LOCATION

LAT: 40.51456°N  
LONG: 104.45086°W  
PDOP: 1.4  
ELEV: 4711'  
1/4,1/4: NW1/4SW1/4

#### BOTTOM HOLE

LAT: 40.51313°N  
LONG: 104.48687°W


#### LEGEND

- = ALIQUOT MONUMENT AS DESCRIBED  
○ = CALCULATED POSITION

#### SHEET 1 OF 3

Brian T. Brinkman—On behalf of Lat40°, Inc.  
Colorado Licensed Professional  
Land Surveyor No. 38175



DATE: 10/31/2013  
PROJECT#: 2013042

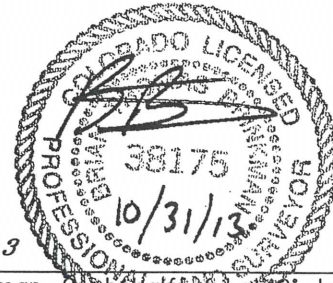



# WELL LOCATION CERTIFICATE

THIS MAP DOES NOT REPRESENT A BOUNDARY SURVEY

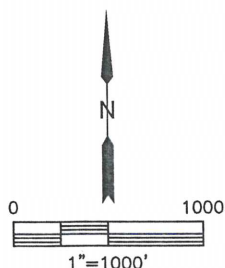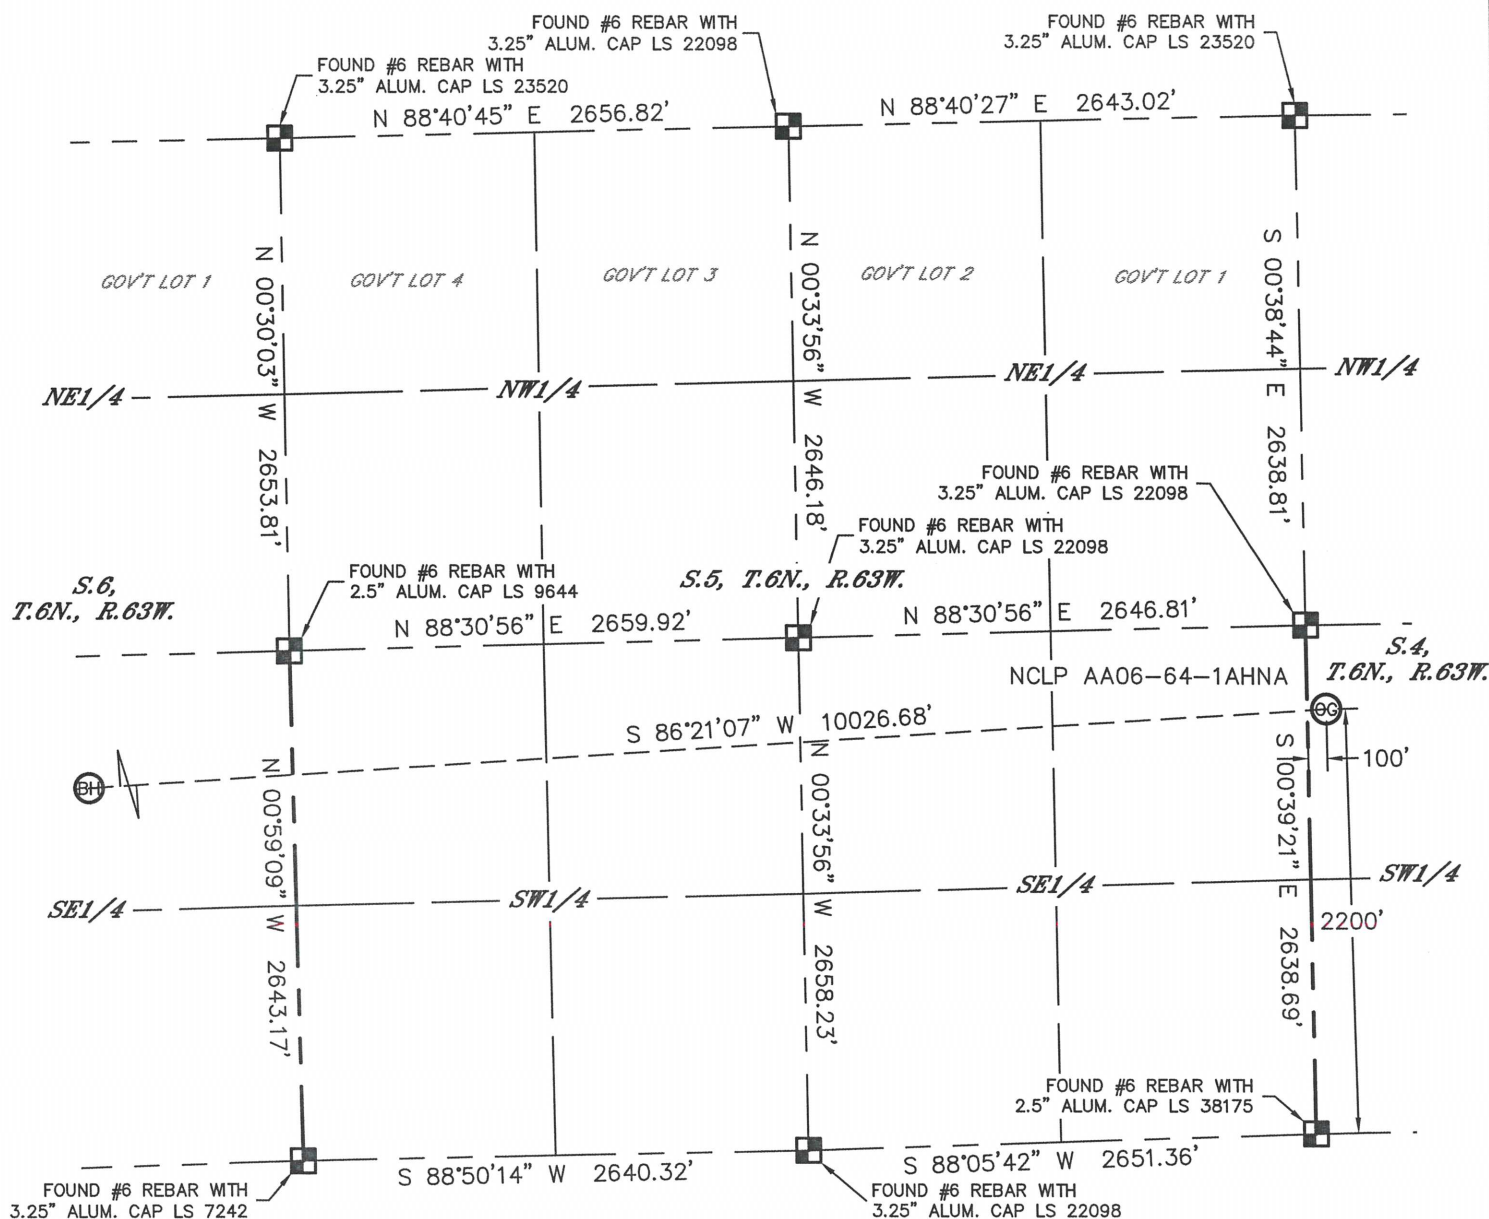SECTION: 4  
TOWNSHIP: 6N  
RANGE: 63W




### LEGEND

-  = ALIQUOT MONUMENT AS DESCRIBED  
 = CALCULATED POSITION

*SHEET 2 OF 3*

Colorado Licensed Professional Land Surveyor No. 38175  

DATE: 10/31/2013  
PROJECT#: 2013042

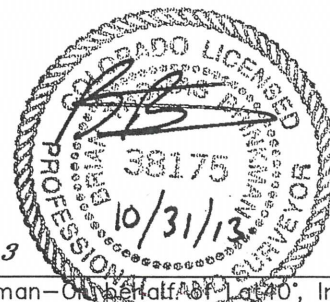





Lat40°, Inc. 1635 Foxtrail Drive, Suite 325 Loveland, CO 970-776-3321

# WELL LOCATION CERTIFICATE

THIS MAP DOES NOT REPRESENT A BOUNDARY SURVEY

SECTION: 4  
TOWNSHIP: 6N  
RANGE: 63W

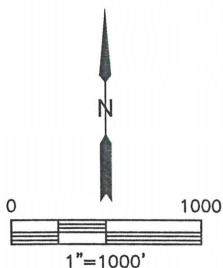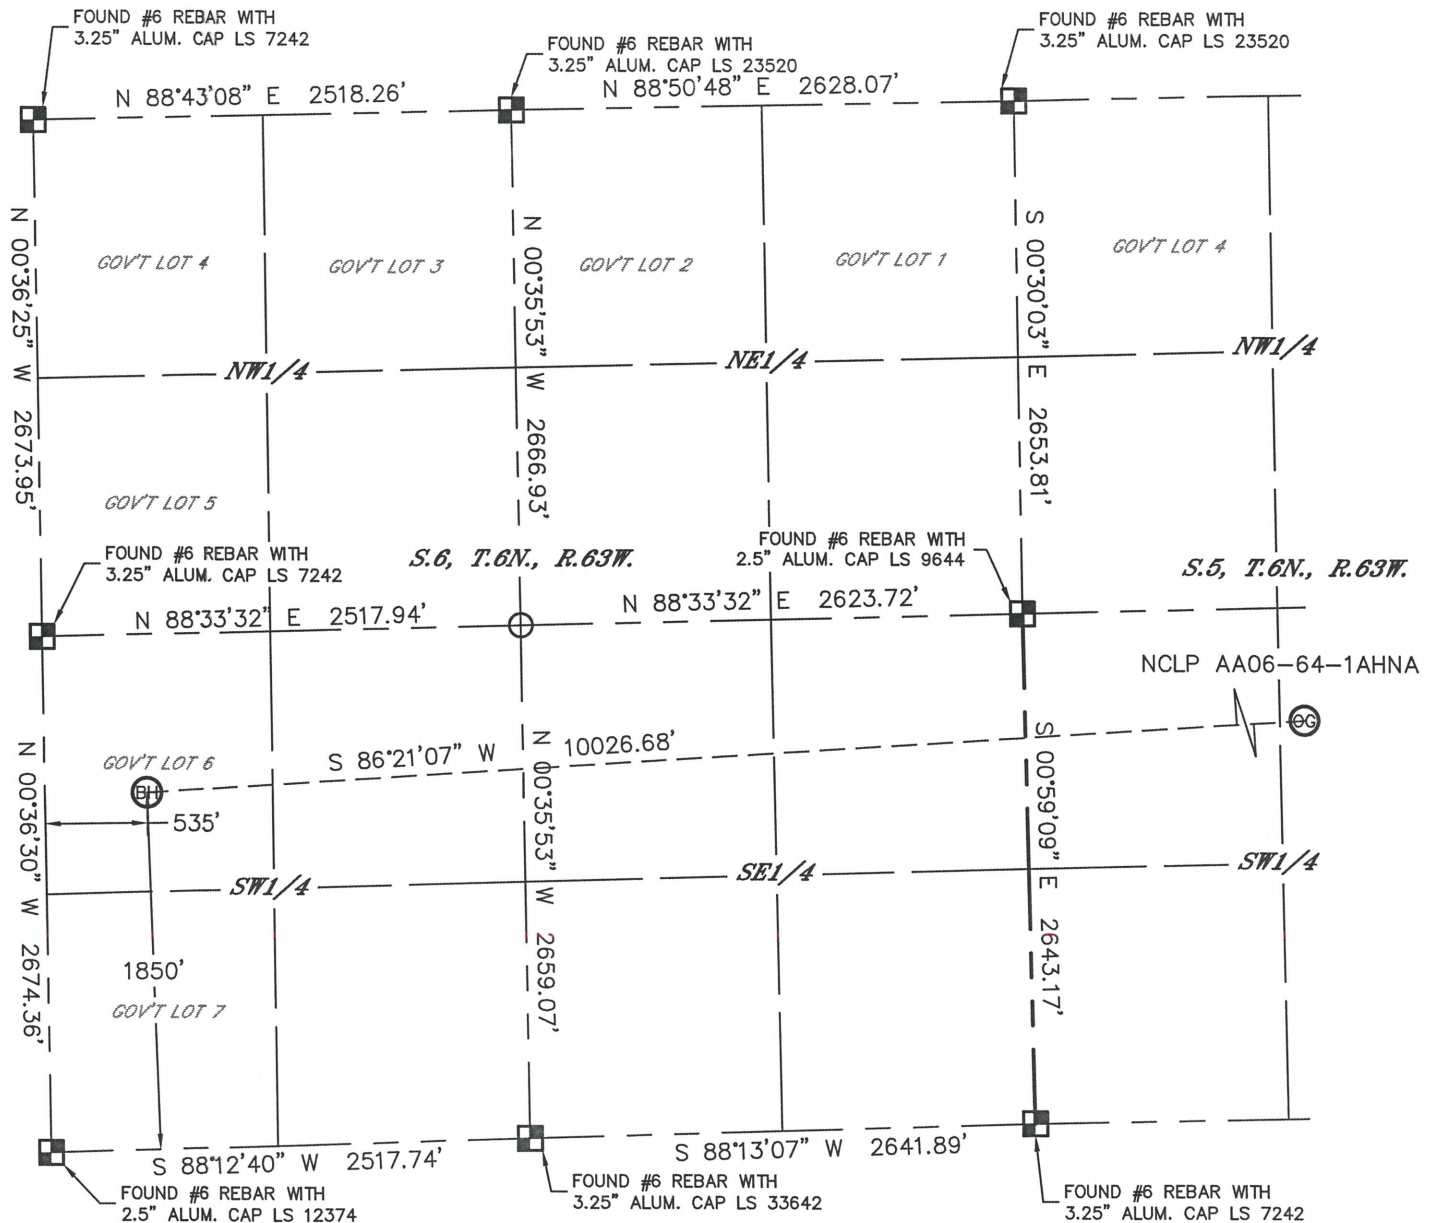


## LEGEND

- = ALIQUOT MONUMENT AS DESCRIBED
- = CALCULATED POSITION

SHEET 3 OF 3

Brian T. Brinkman—On behalf of Lat40°, Inc.  
Colorado Licensed Professional Land Surveyor No. 38175  
DATE: 10/31/2013  
PROJECT#: 2013042



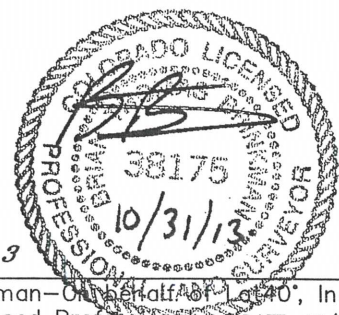




# SITE SKETCH

NCLP AA06-64-1AHNA

SECTION: 4  
TOWNSHIP: 6N  
RANGE: 63W

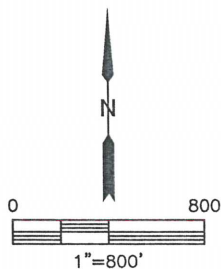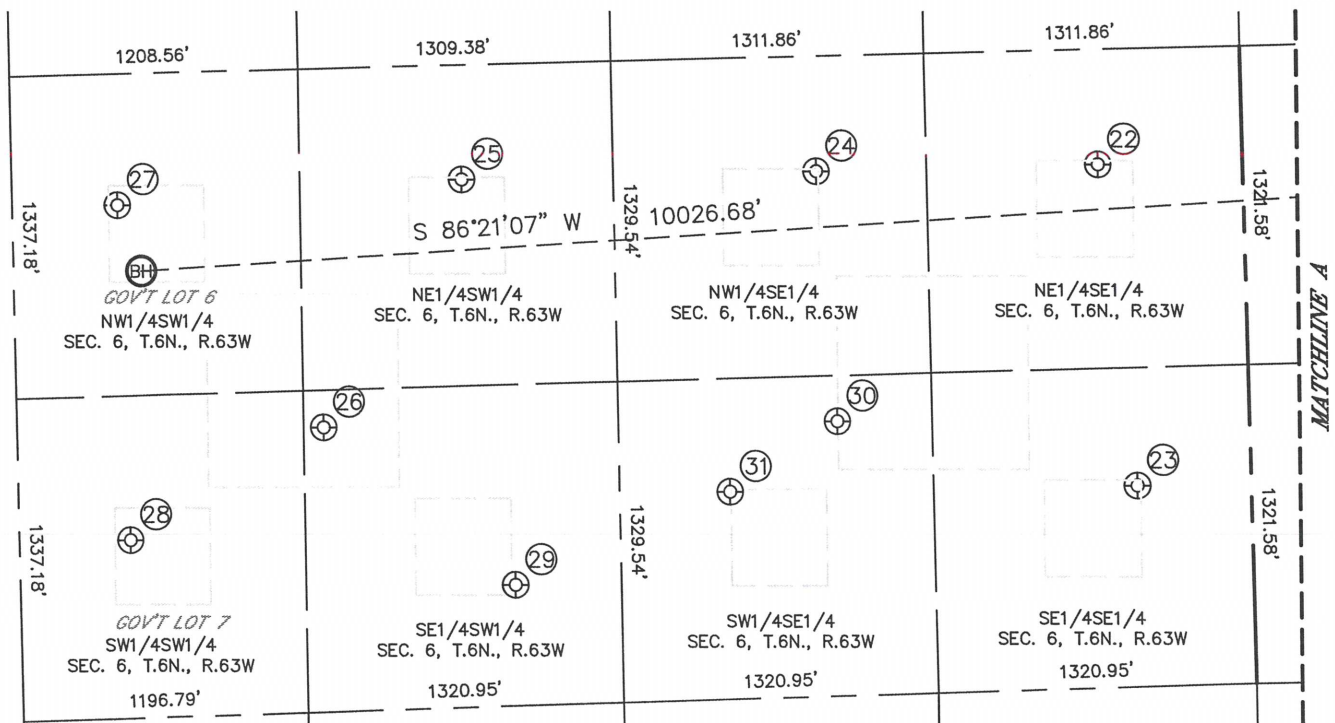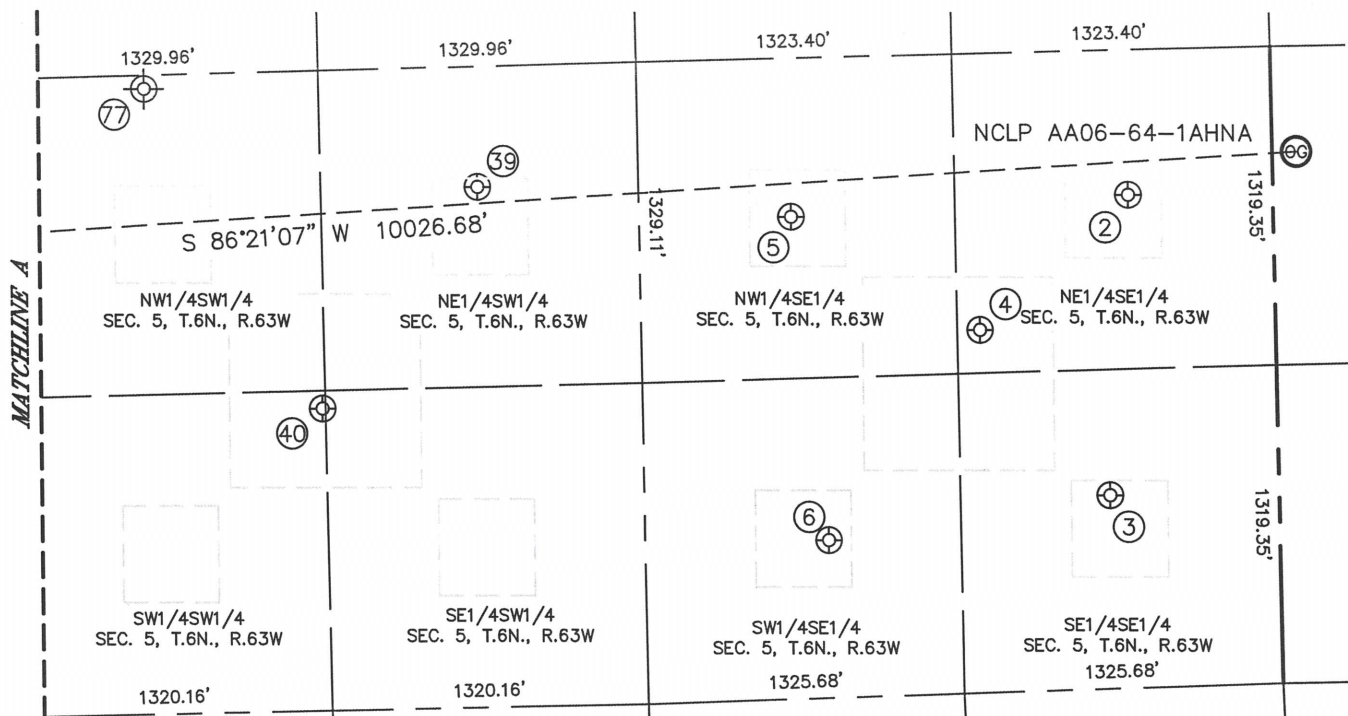

*SHEET 1 OF 2*

DATE: 10/31/2013  
PROJECT#: 2013042



Lat40°, Inc. 1635 Foxtrail Drive, Suite 325 Loveland, CO 970-776-3321

# SITE SKETCH

NCLP AA06-64-1AHNA

SECTION: 4  
TOWNSHIP: 6N  
RANGE: 63W

WELL #	WELL NAME	SHL FOOTAGE				SHL LAT °	SHL LONG °	PDOP	ELEV (FT.)	1/4/1/4
2	NCLP USX AA 5-9	2041	FSL	599	FEL	40.51409	-104.45338	1.2	4717	NESE
3	NCLP USX AA 5-16	800	FSL	699	FEL	40.51068	-104.45374	1.3	4712	SESE
4	CACHE - USX AA 5-23	1502	FSL	1228	FEL	40.51257	-104.45564	1.5	4709	NESE
5	CACHE USX AA 5-10	1996	FSL	2012	FEL	40.51388	-104.45846	1.5	4719	NWSE
6	CASHE USX AA 5-15	654	FSL	1883	FEL	40.51020	-104.45799	1.6	4708	SWSE
22	HAGEMIESTER 43-6	2167	FSL	597	FEL	40.51422	-104.47244	1.9	4708	NESE
23	HAGEMIESTER 44-6	833	FSL	471	FEL	40.51056	-104.47196	1.9	4693	SESE
24	FOSS 6-42	2175	FSL	1778	FEL	40.51418	-104.47668	1.9	4696	NWSE
25	FOSS 6-31	2187	FSL	1885	FWL	40.51413	-104.48201	1.9	4706	NESW
26	FOSS 6-35	1179	FSL	1285	FWL	40.51133	-104.48417	1.8	4705	SESW
27	FOSS 6-32	2127	FSL	441	FWL	40.51389	-104.48720	1.7	4724	NWSW
28	FOSS 6-33	738	FSL	466	FWL	40.51007	-104.48712	2.3	4708	SWSW
29	FOSS 6-34	501	FSL	2076	FWL	40.50951	-104.48133	1.6	4700	SESW
30	FOSS 6-45	1137	FSL	1717	FEL	40.51133	-104.47644	1.4	4695	SWSE
31	FOSS 6-43	859	FSL	2173	FEL	40.51054	-104.47808	1.6	4694	SWSE
39	FOSS-USX AA 05-11	2155	FNL	1985	FWL	40.51426	-104.46315	1.7	4713	NESW
40	FOSS - USX AA 5-25	1252	FSL	1311	FWL	40.51177	-104.46556	1.7	4698	SWSW
77	CHAMPLIN AMOCO 1 #309 (P&A)	2590	FSL	660	FWL	40.51544	-104.46814	NA	4700	NWSW

NOTE: THE ABANDONED WELL DATA SHOWN IN RED ABOVE WAS OBTAINED FROM COGCC SCOUT CARDS.