

WPX Energy Rocky Mountain LLC

SAVAGE RWF 421-35

RULISON Field


SHL 1158' FNL 1188' FWL (NW/4 NW/4) Section 35 T6S R94W 6th PM

BHL 399' FNL 1795' FWL (NE/4 NW/4) Section 35 T6S R94W 6th PM

Garfield County Colorado

Formation Tops

(Measured Depths)

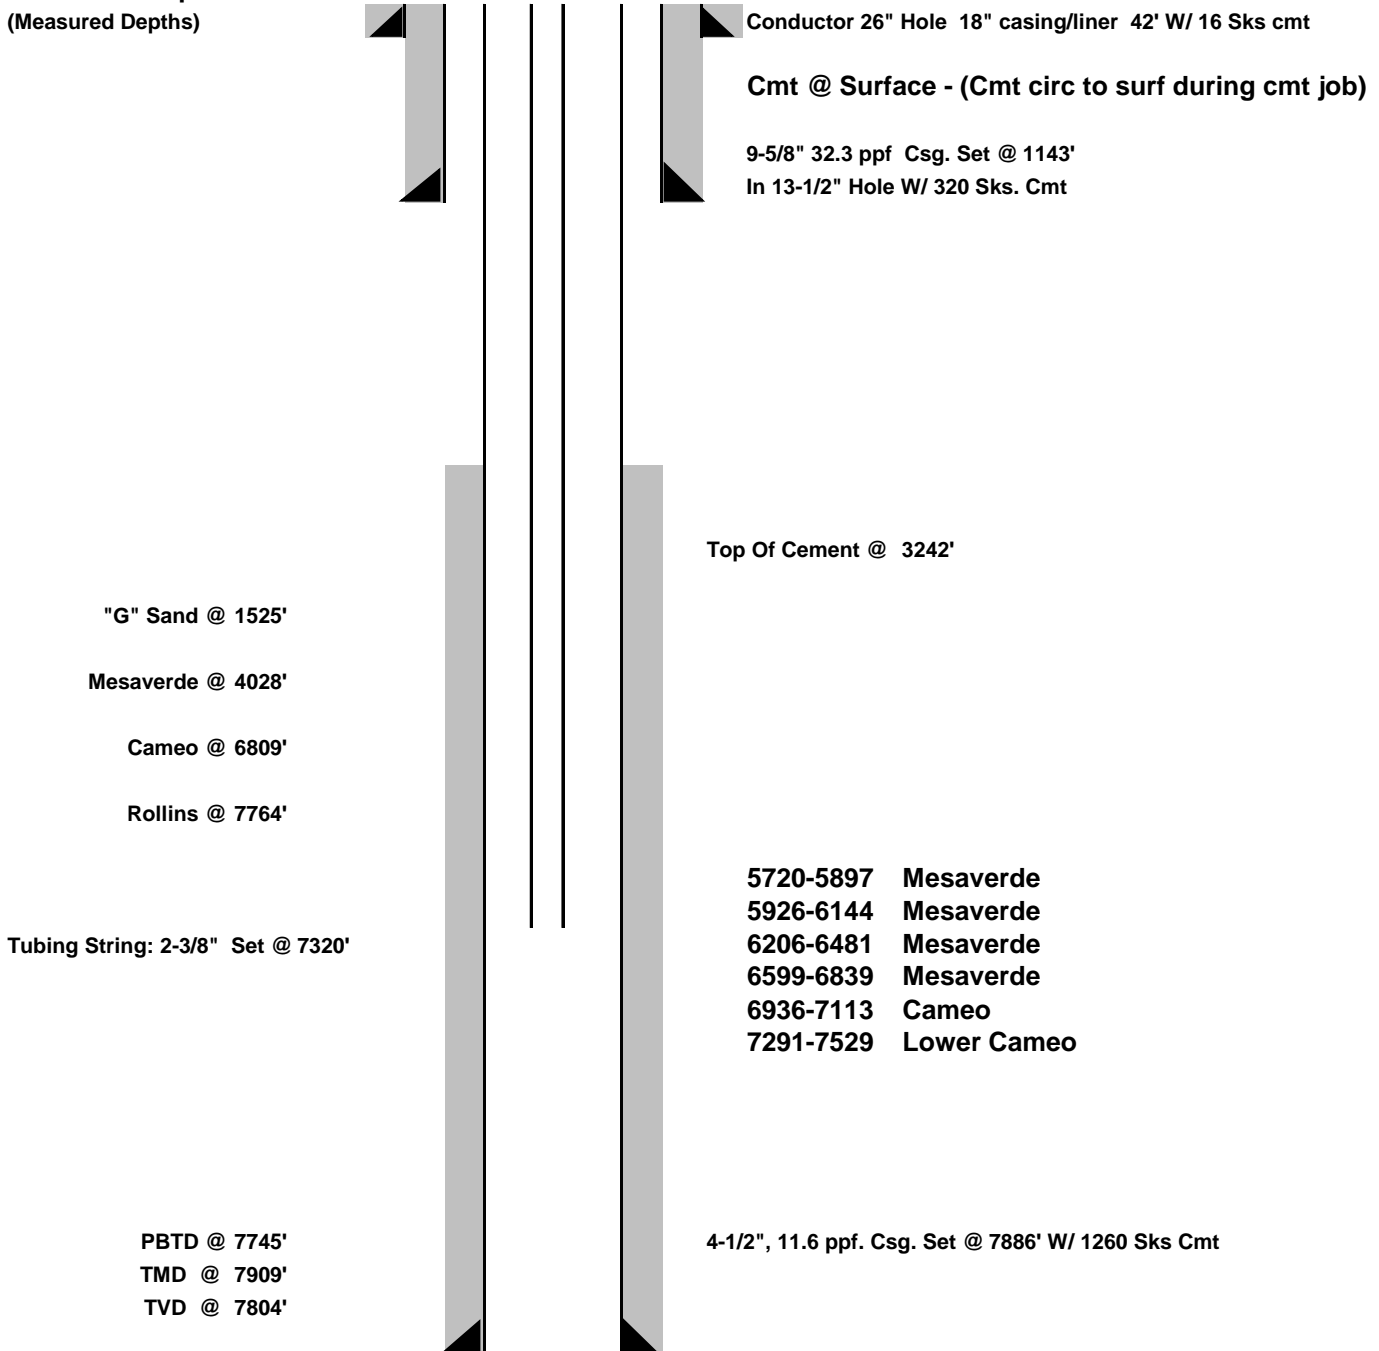

DATE CREATED: 1/14/2014

NOTE: THIS IS NOT TO SCALE.

****FINAL****