

**KERR-MCGEE OIL AND GAS ONSHORE LP**

**RANKIN J WALTER UN 2**

**NW NW 19 3N 67W -- --**

**WELD,COLORADO**

**01/09/2014**

**AREA: S2**

**ROUTE: S25**

**Spud: 06/30/1980**

**WINS No.: 74286**

**AFE/WO#: 2080670**

**API#: 0512309929**

**GL: 4893**

**KB: 4906**

**MTD: 7746**


**TVD: 7746**

**LOG MD: 7743**

**PBMD: 7767**

**PBTVD: 7767**

**Directions: WCR 13 & WCR 32, E 1/16, S 1/2 INTO**

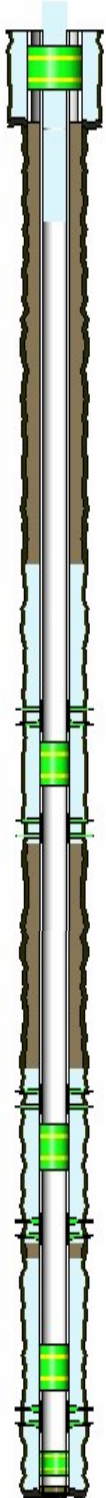

<u>HOLE SECTIONS</u>	<u>Size</u>	<u>Top</u>	<u>Btm</u>	<u>TD Date</u>
SURFACE	12.25	13	330	07/02/1980
PRODUCTION	7.88	331	7815	07/07/1980

<u>TUBULARS</u>	<u>Tool Type</u>	<u>Joints</u>	<u>Size</u>	<u>Weight</u>	<u>Grade</u>	<u>Thread</u>	<u>Top D</u>	<u>Bottom D</u>
SURFACE CASING	Casing	10	8.63	24.00			13	330
PRODUCTION CASING	Casing		4.50	10.5 &			13	7766
			4.50				7766	7767
	Casing		4.50				7767	7811
	Casing Guide Shoe		4.50				7811	7812
BRIDGE PLUG	Cast Iron Bridge Plu		4.50				7600	7602
CAST IRON CEMENT RETAINER	Cement Retainer		4.50				4550	4552
CAST IRON CEMENT RETAINER	Cement Retainer		4.50				6550	6552
BRIDGE PLUG	Cast Iron Bridge Plu	1	8.63				95	97

<u>CEMENT JOBS</u>	<u>Stage</u>	<u>Sacks</u>	<u>Cement Jobs</u>	<u>Top D</u>	<u>Btm D</u>	<u>cbl</u>
SURFACE CASING	STAGE 1	300	LEAD UNKNOWN	13	330	No
PRODUCTION CASING	STAGE 1	200	UNKNOWN	6970	7815	Yes
PRODUCTION CASING	SQUEEZE JOB	226	LEAD NEAT	3615	4390	Yes
PRODUCTION CASING	ABANDONMENT PLUC	200	LEAD FRESH WATER	3485	4746	No
PRODUCTION CASING	ABANDONMENT PLUC	130	LEAD FRESH WATER	6360	6871	No
PRODUCTION CASING	ABANDONMENT PLUC	300	LEAD FRESH WATER	373	1030	No
PRODUCTION CASING	ABANDONMENT PLUC			0	370	No

<u>PERFORATIONS</u>	<u>Formation</u>	<u>Zone</u>	<u>Top</u>	<u>Btm</u>	<u>Date</u>	<u>Reason</u>	<u>Comments</u>
			4470	4472	11/26/2013	CEMENT SQUEEZE	
			4745	4746	11/26/2013	CEMENT SQUEEZE	
			6470	6472	11/25/2013	CEMENT SQUEEZE	
			6870	6871	11/22/2013	CEMENT SQUEEZE	
J SAND			7664	7694	01/01/1981	PRODUCTION	

**Comments:**