




Well Name: RWF 411-35
 Surface Location: RWF 11-35 Pad
 North American Datum 1983 , US State Plane 1983. Colorado Central Zone
 Ground Elevation: 5473.00

+N/-S	+E/-W	Northing	Easting	Latitude	Longitude	Slot
0.00	0.00	1610484.80	2333819.69	39.48579	-107.86059	A7

KB @ 5494.00usft (Cyclone 17)

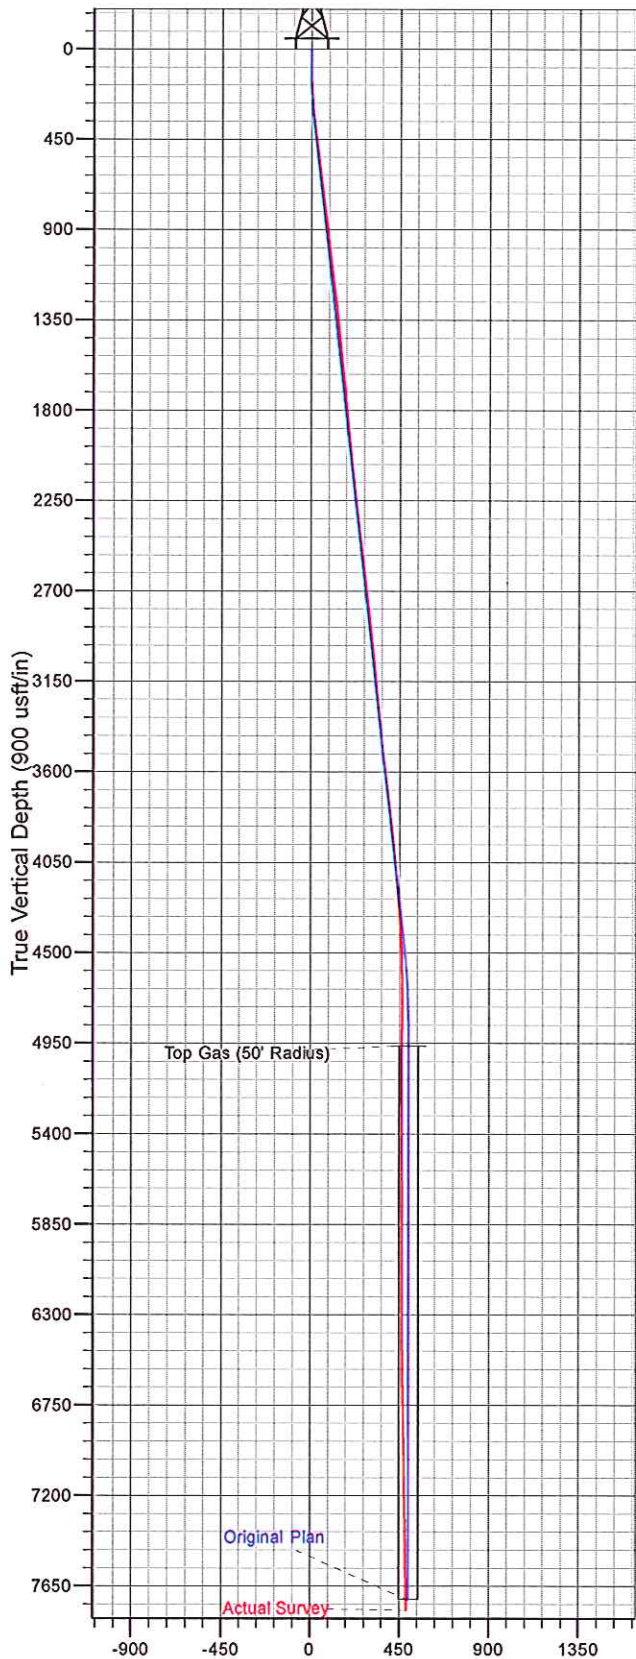

Vertical Section at 264.38° (900 usft/in)

