


WPX Energy Rocky Mtn LLC
RWF 411-35
 API #05-045-21847-00
 1165' FNL x 1192' FWL - SHL
 1224' FNL x 707' FWL - BHL
 (NWNW) Sec. 35-T6S-R94W
 Garfield County, Colorado
 Rulison Prospect

FINAL
 DATED 01-14-14

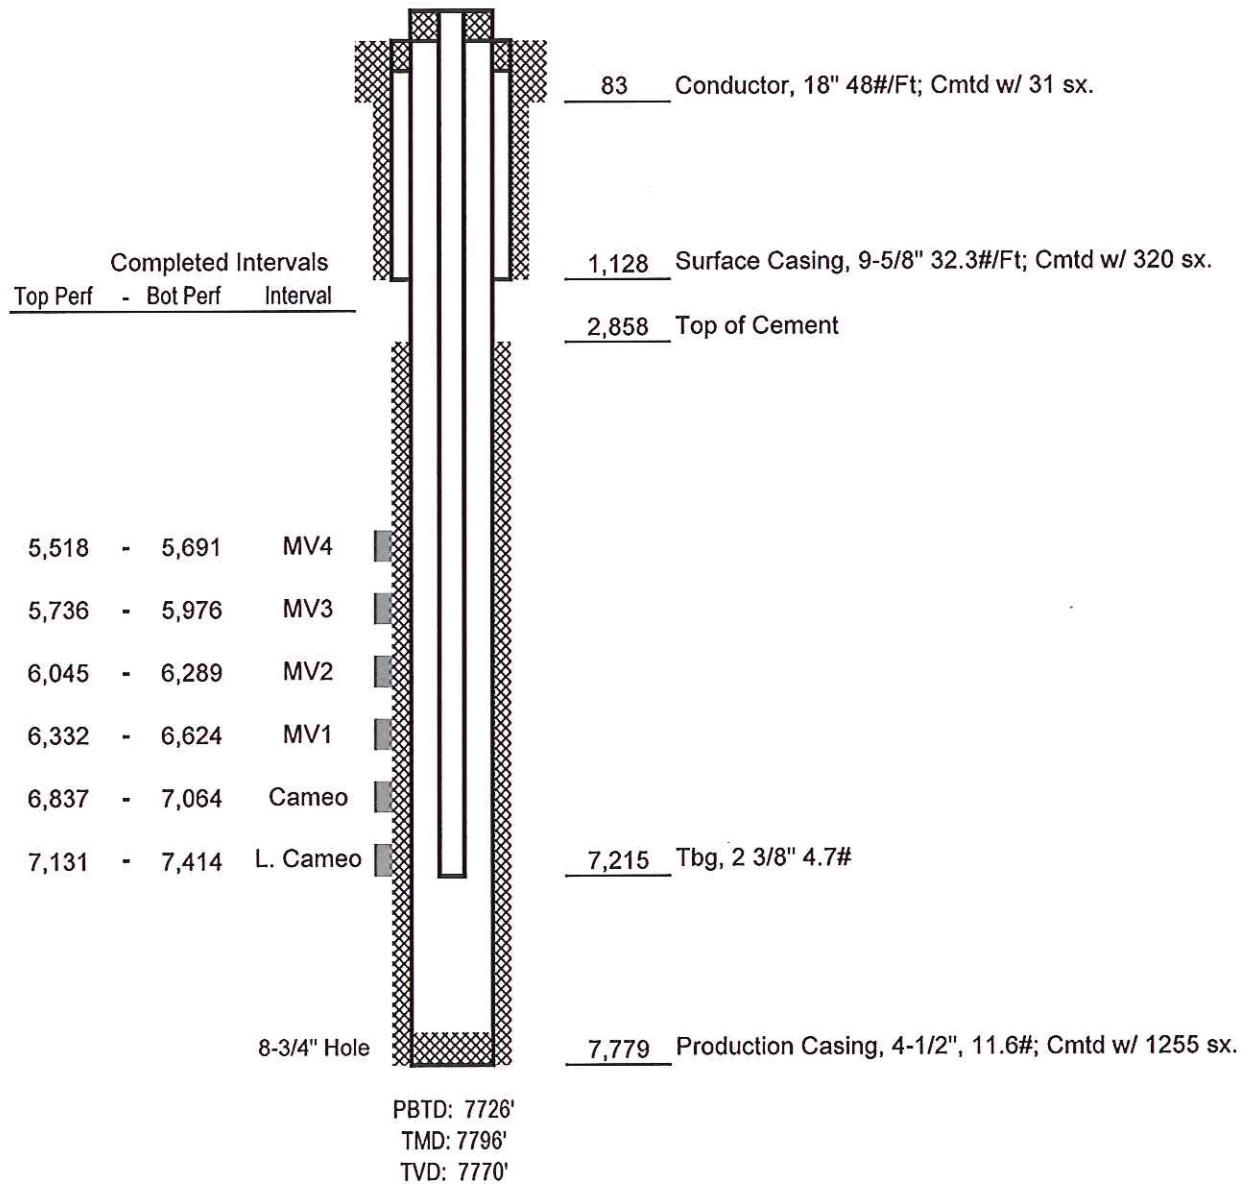

Not to Scale