

Job: 08246 Aloha Mula #8

Inv # 2889


Physical Address: 345 Comanche St.
Mail to: Box 384, Kiowa, CO 80117
Ph. 303-621-8672 - Fax 303-621-7749
www.highprairiesurvey.com

High Prairie Surveying of Kiowa, Colorado has in accordance with a request from **Wiepking Fullerton Energy** has determined the location of **Aloha Mula #8** to be **1984 feet FSL**, and **656 feet FWL**, (90° off Section lines) of SECTION **19**, Township **10s**, Range **55w** of the 6th Principal Meridian, **Lincoln County**, Colorado.

Date: Staked on 12/16/13 drawn on 12/24/13.

Re: Staked by Elijah Frane

Drawn: Drawn by Dustin Cofer

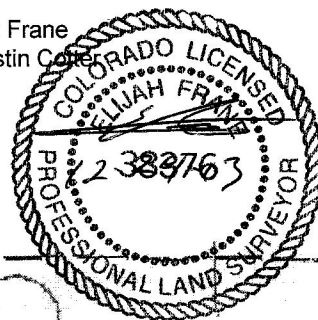

Reference Area

