


**WPX Energy Rocky Mountain LLC
FEDERAL PA 414-12
Parachute Field**

**SHL 2577' FSL 1724' FWL (NE/4 SW/4) Section 12 T7S R95W 6th PM
BHL 560' FSL 328' FWL (SW/4 SW/4) Section 2 T7S R95W 6th PM
Garfield County Colorado**

**Formation Tops
(Measured Depths)**

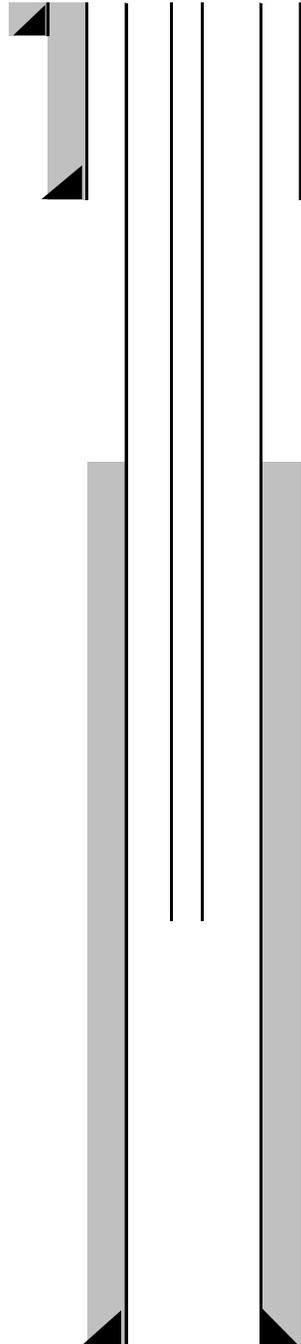

Conductor 26" Hole 18" casing/liner 40' W/ 15 Sks cmt

Cmt @ Surface - (Cmt circ to surf during cmt job)

**9-5/8" 32.3 ppf Csg. Set @ 1038'
In 13-1/2" Hole W/ 675 Sks. Cmt**

Top Of Cement @ 5006'

"G" Sand @ 2959'

Mesaverde @ 5140'

Cameo @ 7503'

Rollins @ 8478'

Tubing String: 2-3/8" Set @ 8025'

**6430-6675' Mesaverde
6725-6922' Mesaverde
6963-7162' Mesaverde
7220-7494' Mesaverde
7563-7812' Mesaverde/Cameo
8114-8409' Cameo**

**PBTD @ 8631'
TMD @ 8680'
TVD @ 8109'**

4-1/2", 11.6 ppf. Csg. Set @ 8664' W/ 965 Sks Cmt

DATE CREATED: 1/15/2014

**NOTE: THIS IS NOT TO SCALE.
FINAL**