

WPX ENERGY ROCKY MOUNTAIN, LLC
FEDERAL RU 12-5
MAMM CREEK Field
SHL 221' FNL 2604' FWL (LOT 2) BHL 871' FNL 693' FWL
Section 5-T7S-R93W 6th PM
Garfield County, Colorado

Formation Tops
(Measured Depths)

top of gas @8120'


G Sand @ 4060'

Mesaverde @ 6141'

Cameo @ 8452'

Rollins @ 9421'

PBTD @
TMD @ 10218'
TVD @ 9907'

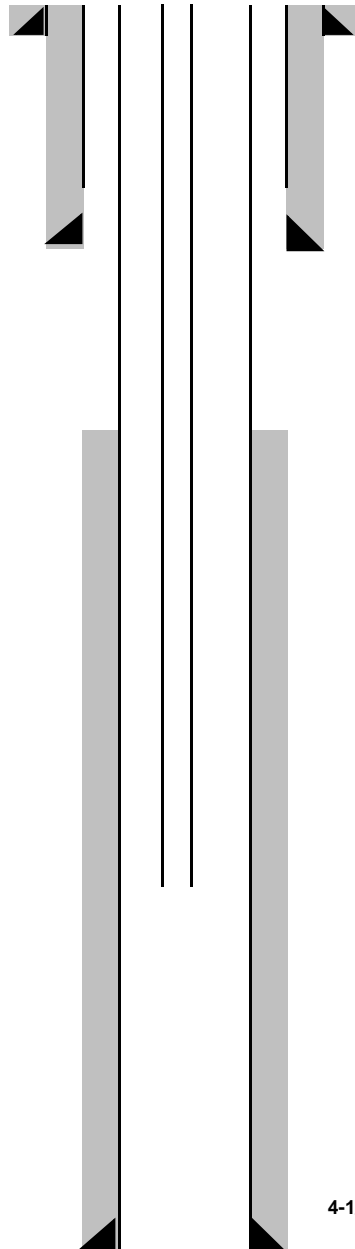

Cmt @ Surface - (Cmt circ to surf during cmt job)

9 5/8" 32.3# ppf Csg. Set @1162
In 12 1/4" Hole W/320 Sks. Cmt

Top Of Cement @ 5958'

4-1/2", 11.6 ppf. Csg. Set @10207' W/1020 sks Cmt