

**KERR-MCGEE OIL AND GAS ONSHORE LP**

**EVERIST 39-10**

**SW SE 10 2N 68W 1,139' FSL 1,475' FEL**

**WELD,COLORADO**

**01/15/2014**

**AREA: S2**

**ROUTE: S22 Spud: 08/03/2008**

**WINS No.: 99218**

**AFE/WO#: 88436949**

**API#: 0512326796**

**GL: 4861**

**KB: 4876**

**MTD: 7870**


**TVD: 7634**

**LOG MD: 3555**

**PBMD: 7774**

**PBTVD: 7537**

**Directions: WCR 20-1/2 & WCR 7; EAST 5/10 MILE; NORTH 4/10 MILE; EAST 2-10 MILE; NORTH 3/10 MILE INTO LOCATION**

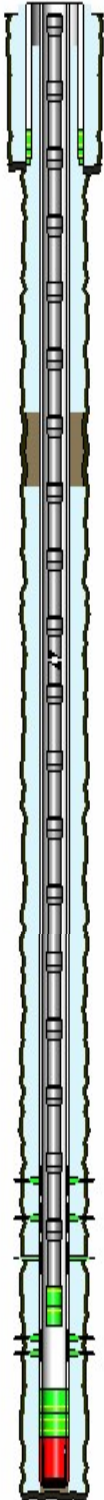

| <u>HOLE SECTIONS</u> | <u>Size</u> | <u>Top</u> | <u>Btm</u> | <u>TD Date</u> |
|----------------------|-------------|------------|------------|----------------|
| SURFACE              | 12.25       | 15         | 835        | 08/04/2008     |
| PRODUCTION           | 7.88        | 835        | 7870       | 08/06/2008     |

| <u>TUBULARS</u>          | <u>Tool Type</u>  | <u>Joints</u> | <u>Size</u> | <u>Weight</u> | <u>Grade</u> | <u>Thread</u> | <u>Top D</u> | <u>Bottom D</u> |
|--------------------------|-------------------|---------------|-------------|---------------|--------------|---------------|--------------|-----------------|
| <b>SURFACE CASING</b>    |                   |               |             |               |              |               |              |                 |
|                          | Casing            | 17            | 8.63        | 24.00         | J-55         | STC           | 14           | 771             |
|                          | Baffle            | 1             | 8.63        |               | J-55         |               | 771          | 772             |
|                          | Shoe Joint        | 1             | 8.63        | 24.00         | J-55         | STC           | 772          | 816             |
|                          | Saw Tooth Shoe    | 1             | 9.00        |               | J-55         |               | 816          | 817             |
| <b>PRODUCTION CASING</b> |                   |               |             |               |              |               |              |                 |
|                          | Casing            | 191           | 4.50        | 11.60         | I-80         | LTC           | 14           | 7774            |
|                          | Latch Down Baffle | 1             | 4.50        |               | I-80         |               | 7774         | 7774            |
|                          | Shoe Joint        | 1             | 4.50        | 11.60         | I-80         | LTC           | 7774         | 7802            |
|                          | Casing Float Shoe | 1             | 4.50        |               | I-80         |               | 7802         | 7803            |
| <b>PRODUCTION TUBING</b> |                   |               |             |               |              |               |              |                 |
|                          | Tubing            | 242           | 2.38        | 4.70          | J-55         | External-Ups  | 15           | 7603            |
|                          | XN Profile Nipple | 1             | 2.38        |               |              |               | 7603         | 7605            |
|                          | Notched Collar    | 1             | 2.38        |               |              |               | 7605         | 7605            |

| <u>CEMENT JOBS</u>       | <u>Stage</u>       | <u>Sacks</u> | <u>Cement Jobs</u> | <u>Top D</u> | <u>Btm D</u> | <u>cbl</u> |
|--------------------------|--------------------|--------------|--------------------|--------------|--------------|------------|
| <b>SURFACE CASING</b>    |                    |              |                    |              |              |            |
|                          | PRIM CMT 1ST STAGE | 520          | LEAD TYPE 3        | 15           | 819          | No         |
| <b>PRODUCTION CASING</b> |                    |              |                    |              |              |            |
|                          | PRIM CMT 1ST STAGE | 445          | LEAD ECONOCEM      | 3157         | 6854         | Yes        |
|                          | PRIM CMT 1ST STAGE | 134          | TAIL FRACCEM       | 6854         | 7840         | Yes        |
| <b>PRODUCTION CASING</b> |                    |              |                    |              |              |            |
|                          | ONE INCH JOB       | 420          | LEAD FRESH WATER   | 220          | 2430         | Yes        |

| <u>PERFORATIONS</u> | <u>Formation</u> | <u>Zone</u> | <u>Top</u> | <u>Btm</u> | <u>Date</u> | <u>Reason</u> | <u>Comments</u> |
|---------------------|------------------|-------------|------------|------------|-------------|---------------|-----------------|
|                     | NIOBRARA         |             | 7360       | 7363       | 09/30/2008  | PRODUCTION    |                 |
|                     | NIOBRARA         |             | 7418       | 7431       | 09/30/2008  | PRODUCTION    |                 |
|                     | NIOBRARA         |             | 7504       | 7512       | 09/30/2008  | PRODUCTION    |                 |
|                     | CODELL           |             | 7632       | 7648       | 09/29/2008  | PRODUCTION    |                 |

**Comments:**