

Physical Address: 345 Comanche St.
Mail to: Box 384, Kiowa, CO 80117
Ph. 303-621-8672 - Fax 303-621-7749
www.highprairiesurvey.com


Job # 11094 Ma-State #10

Inv # 2884

High Prairie Surveying of Kiowa, Colorado has in accordance with a request from **Wiepking Fullerton** has determined the location of **Ma-State #10** to be **1980 feet FSL**, and **660 feet FEL**, (90° off Section lines) of **SECTION 24**, Township **10s**, Range **56w** of the 6th Principal Meridian, **Lincoln County**, Colorado.

Date: Staked 12/16/13 drawn on 12/23/13.

Re: Staked by Elijah Frane
Drawn: Drawn by Dustin Cotter

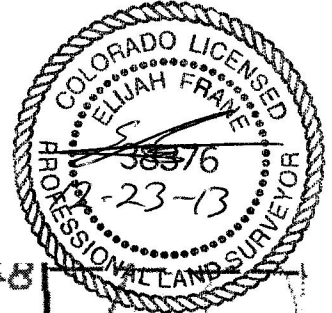

Reference Area

