


**WPX Energy Rocky Mountain LLC  
 WPX ENERGY RMV 163-4  
 RULISON Field**

**SHL 435' FNL 1695' FEL (NW/4 NE/4) LOT 2, Section 4 T7S R94W 6th PM  
 BHL 2408' FNL 2132' FEL (SW/4 NE/4) Section 4 T7S R94W 6th PM  
 Garfield County Colorado**

**Formation Tops  
 (Measured Depths)**

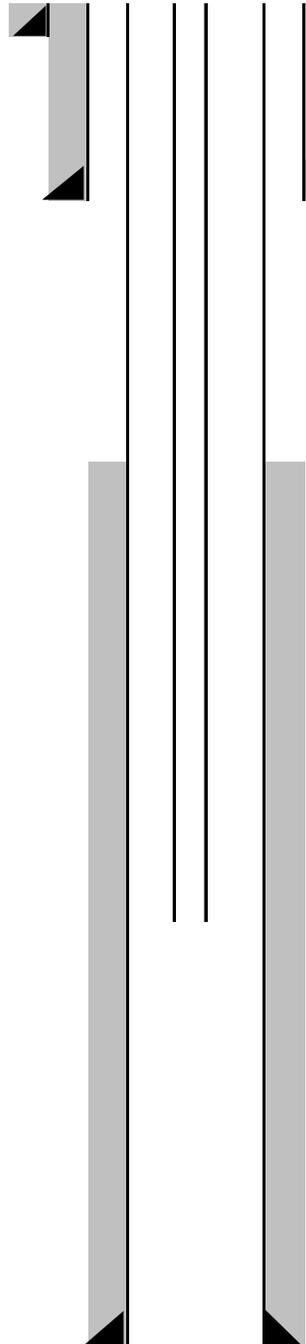

Conductor 26" Hole 18" casing/liner 42' W/ 16 Sks cmt

**Cmt @ Surface - (Cmt circ to surf during cmt job)**

9-5/8" 32.3 ppf Csg. Set @ 1192'

In 13-1/2" Hole W/ 320 Sks. Cmt

**Top Of Cement @ 3930'**

"G" Sand @ 2133'

Mesaverde @ 4791'

Cameo @ 7380'

Rollins @ 8270'

**Tubing String: 2-3/8" Set @ 7887'**

6172-6462' Mesaverde  
 6643-6790' Mesaverde  
 6850-7163' Mesaverde  
 7258-7518' Mesaverde  
 7581-7817' Cameo  
 7934-8109' Lower Cameo

PBTD @ 8371'

TMD @ 8470'

TVD @ 8028'

4-1/2", 11.6 ppf. Csg. Set @ 8456' W/ 1190 Sks Cmt

**DATE CREATED:** 1/20/2014

**NOTE: THIS IS NOT TO SCALE.**

**\*\*FINAL\*\***