

PDC Energy
 Anderson 1-10-6-66
 SESE 10 - 6N - 65W
 Weld County, CO
 Current Wellbore - NOT TO SCALE!!!
 12/16/2013

API#: 05-123-11374


GL Elevation: 4832'

Surface Casing:
8 5/8" 24# @ 295' W/ 200 sks cmt.

First String
4 1/2" 11.6# @ 7342' w/ ??? sks cmt

Second String
0

Perforations	
	Codell: 7288'-7300'
Old:	0
	0
	0
	0
New:	0
	0
	0
	0

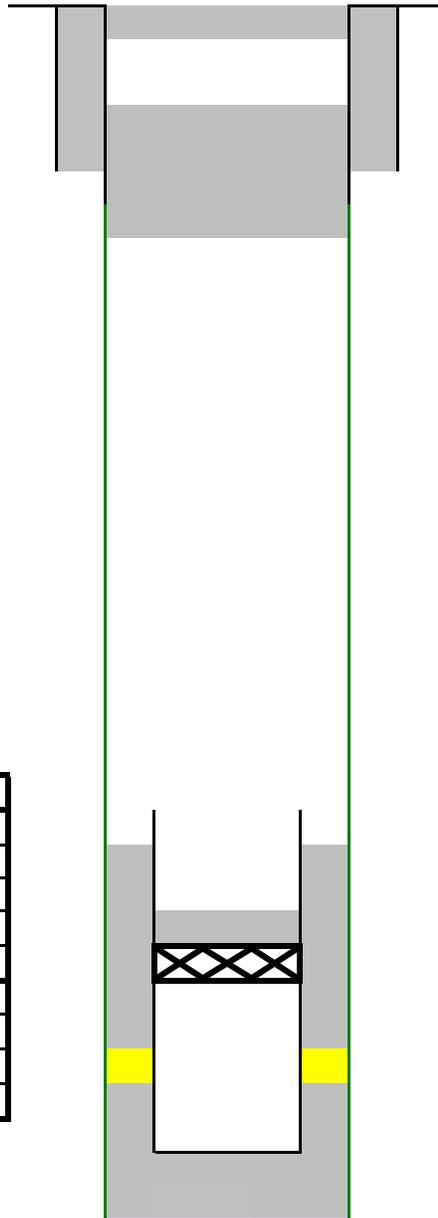

Parkman

Top of Cement:
0

Top of casing - 5765'

CIBP @ 5810'

Codell

PBTD:	7342'
Casing TD:	0

NOTES

Casing cut @ 5765', 35 sacks 1/2 in 1/2 out of surface casing, 10 sacks at surface