


KERR-MCGEE OIL AND GAS ONSHORE LP

**KERN 1
SW SW 4 3N 66W -- --
WELD,COLORADO
01/16/2014**

AREA: N5 ROUTE: N53 Spud: 05/16/1975 WINS No.: 76235 AFE/WO#: 2092142 API#: 0512308410

GL: 4800 KB: 4810 MTD: 7925 TVD: 7925 LOG MD: 7892 PBMD: 7865 PBTVD: 7865

Directions: WCR 29 & WCR 36, N 1/8, E 100 YDS, N 100 YDS, E INTO

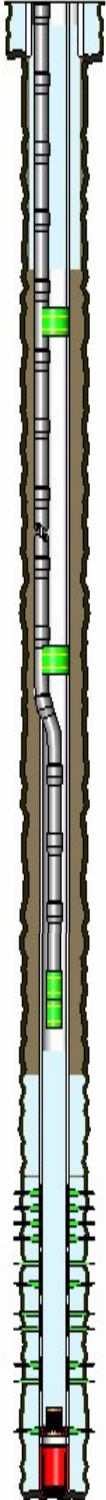

<u>HOLE SECTIONS</u>	<u>Size</u>	<u>Top</u>	<u>Btm</u>	<u>TD Date</u>				
SURFACE	12.25	10	360	05/17/1975				
PRODUCTION	7.88	356	7925	05/27/1975				
<u>TUBULARS</u>	<u>Tool Type</u>	<u>Joints</u>	<u>Size</u>	<u>Weight</u>	<u>Grade</u>	<u>Thread</u>	<u>Top D</u>	<u>Bottom D</u>
SURFACE CASING	Casing	8	8.63	28.00	J-55	ST&C	10	356
PRODUCTION CASING	Casing	254	4.50	11.60	K-55	8RD	10	7865
	Casing Float Collar	1	4.50				7865	7868
	Casing	2	4.50	11.60	K-55	8RD	7868	7920
	Casing Guide Shoe	1	4.50				7920	7921
SAND PLUG	Sand Screen						7440	7870
CASING PATCH	Casing Patch	1	4.50				2010	2014
PRODUCTION TUBING	Tubing	190	2.38	4.70	J-55	External-Ups	10	5985
	XN Profile Nipple	1	2.38				5985	5986
	Notched Collar	1	2.38				5986	5986
CAST IRON CEMENT RETAINER	Cement Retainer	1	4.50				4042	4044
<u>CEMENT JOBS</u>	<u>Stage</u>	<u>Sacks</u>	<u>Cement Jobs</u>	<u>Top D</u>	<u>Btm D</u>	<u>cbt</u>		
SURFACE CASING	STAGE 1	300	G	10	356	No		
PRODUCTION CASING	PRIM CMT 1ST STAGE	250	LEAD FRESH WATER	6960	7921	Yes		
PRODUCTION CASING	SQUEEZE 1	200	LEAD 50/50 POZ-MIX	6300	6950	Yes		
PRODUCTION CASING	ABANDONMENT PLUC	110	LEAD FRESH WATER	6145	7700	No		
CAST IRON CEMENT RETAINER	SQUEEZE JOB			3849	5150	No		
--None--	ABANDONMENT PLUC	515	LEAD FRESH WATER	150	1760	No		
SURFACE CASING	ABANDONMENT PLUC	120	LEAD FRESH WATER	150	500	No		
SURFACE CASING	ABANDONMENT PLUC			150	500	No		
<u>PERFORATIONS</u>	<u>Formation</u>	<u>Zone</u>	<u>Top</u>	<u>Btm</u>	<u>Date</u>	<u>Reason</u>	<u>Comments</u>	
	SUSSEX		4000	4001	11/22/2013	CEMENT SQUEEZE		
	SUSSEX		5150	5151	11/22/2013	CEMENT SQUEEZE		
			6950	6951	10/19/1992	CEMENT SQUEEZE		
	NIOBRARA	A	7018	7028	10/23/1992	PRODUCTION	1 SPF	
	NIOBRARA	A	7028	7036	08/25/2010	PRODUCTION		
	NIOBRARA	B	7084	7096	10/23/1992	PRODUCTION	1 SPF	
	NIOBRARA	B	7088	7096	08/25/2010	PRODUCTION		
	NIOBRARA	C	7172	7178	08/25/2010	PRODUCTION		
	CODELL		7312	7322	11/10/1990	PRODUCTION	2 SPF	
	CODELL		7312	7324	08/25/2010	PRODUCTION		

KERR-MCGEE OIL AND GAS ONSHORE LP

KERN 1

SW SW 4 3N 66W -- --

WELD,COLORADO

01/16/2014

AREA: N5

ROUTE: N53

Spud: 05/16/1975

WINS No.: 76235

AFE/WO#: 2092142

API#: 0512308410

GL: 4800

KB: 4810

MTD: 7925

TVD: 7925

LOG MD: 7892

PBMD: 7865

PBTVD: 7865

Directions:

WCR 29 & WCR 36, N 1/8, E 100 YDS, N 100 YDS, E INTO

J SAND

7782

7810

10/20/1975

PRODUCTION

1 S per 2'

Comments: