

WPX Energy Rocky Mtn LLC

RWF 321-35

API #05-045-21846-00

1144' FNL x 1182' FWL - (NWNW) - SHL

108' FNL x 2008' FWL - (NENW) - BHL


Sec. 35-T6S-R94W

Garfield County, Colorado

Rulison Prospect

FINAL

DATED 01-22-14

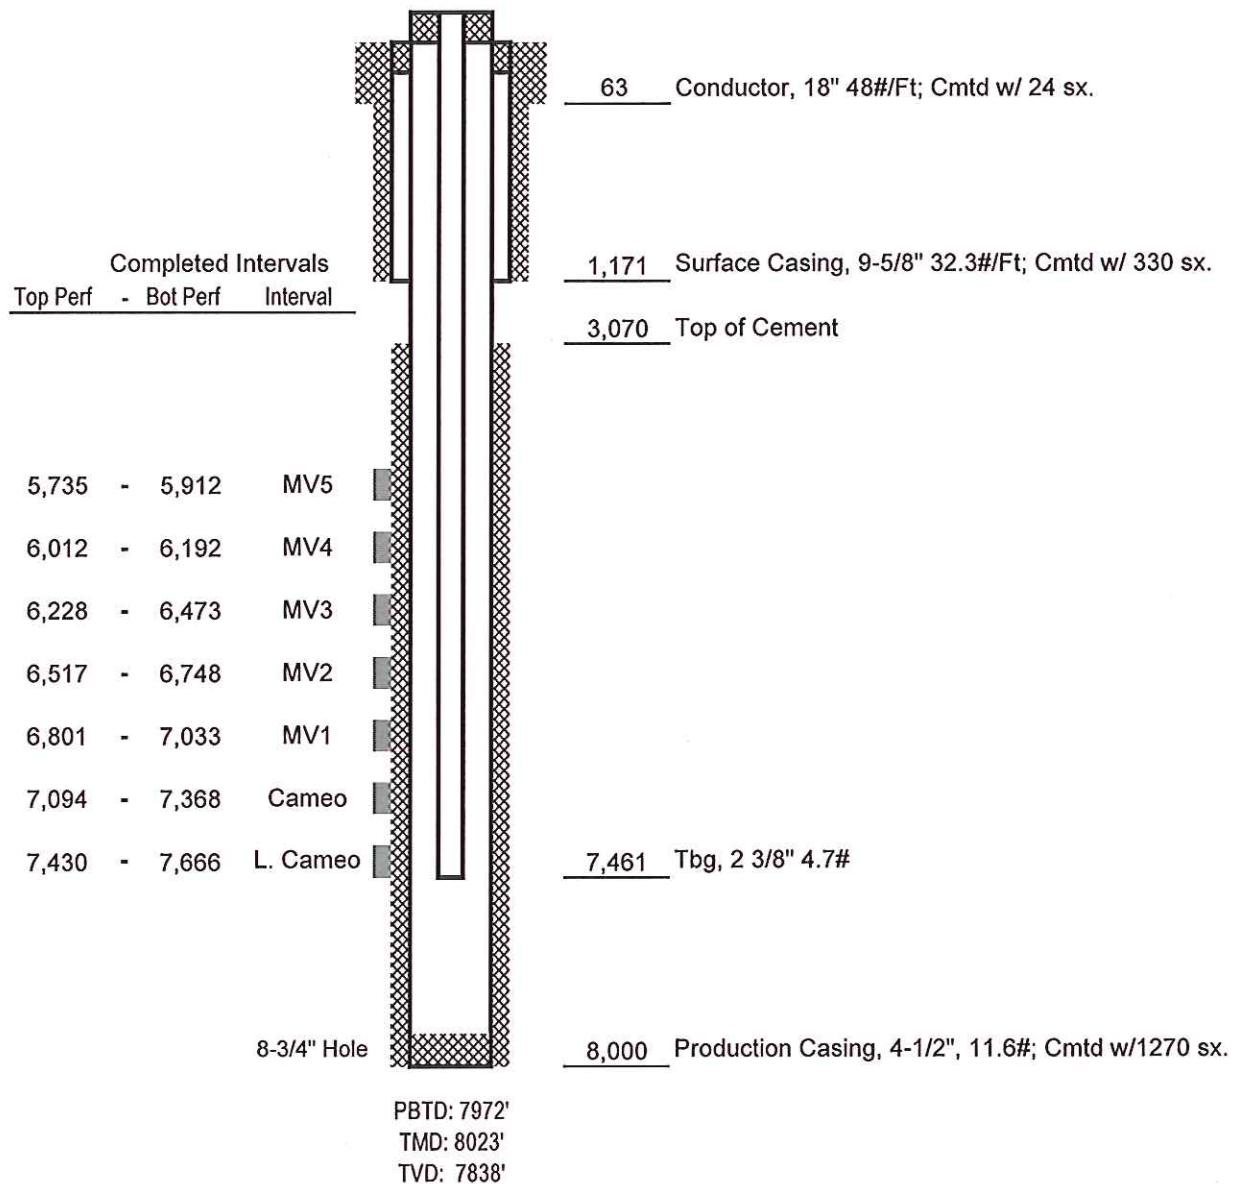

Not to Scale