

**KERR-MCGEE OIL AND GAS ONSHORE LP**

**UNIT A GAS UNIT 1**

**NE NE 16 2N 67W 1,320' FNL 1,100' FEL**

**WELD,COLORADO**

**01/22/2014**

**AREA: S1**

**ROUTE: S15 Spud: 04/15/1971**

**WINS No.: 74434**

**AFE/WO#: 2092705**

**API#: 0512307286**

**GL: 4995**

**KB: 5006**

**MTD: 8120**


**TVD: 8120**

**LOG MD: 8084**

**PBMD: 8069**

**PBTVD: 8069**

**Directions: WCR 19 & WCR 22, S 1/8, W 2/10, S 1/10 INTO**

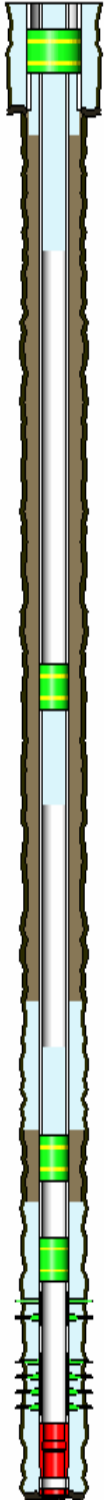

<u>HOLE SECTIONS</u>	<u>Size</u>	<u>Top</u>	<u>Btm</u>	<u>TD Date</u>				
SURFACE	12.25	11	422	04/15/1971				
PRODUCTION	7.88	422	8120	04/29/1971				
<u>TUBULARS</u>	<u>Tool Type</u>	<u>Joints</u>	<u>Size</u>	<u>Weight</u>	<u>Grade</u>	<u>Thread</u>	<u>Top D</u>	<u>Bottom D</u>
SURFACE CASING	Casing		8.63	24	J-55	STC	11	422
PRODUCTION CASING	Casing	250	4.50	11.60	K-55	STC	11	8069
	Float Collar	1	4.50				8069	8070
	Casing	1	4.50	11.60	K-55	STC	8070	8114
	Casing Shoe	1	4.50				8114	8115
BRIDGE PLUG	CIBP With CMT Cap	1	4.50				7954	7955
BRIDGE PLUG	CIBP With CMT Cap	1	4.50				7540	7541
CAST IRON CEMENT RETAINER	Cement Retainer	1	4.50				4440	4441
BRIDGE PLUG	Cast Iron Bridge Plu	1	8.68				150	152
<u>CEMENT JOBS</u>	<u>Stage</u>	<u>Sacks</u>	<u>Cement Jobs</u>			<u>Top D</u>	<u>Btm D</u>	<u>cbl</u>
SURFACE CASING	STAGE 1	300	UNKNOWN			11	422	No
PRODUCTION CASING	STAGE 1	150	50/50 POZMIX			7700	8120	No
PRODUCTION CASING	SQUEEZE JOB	300	LEAD	50/50 POZ-MIX		6554	7490	Yes
PRODUCTION CASING	ABANDONMENT PLUC	50	LEAD	FRESH WATER		6885	7540	No
PRODUCTION CASING	ABANDONMENT PLUC					4440	5130	No
PRODUCTION CASING	ABANDONMENT PLUC					0	1430	No
SURFACE CASING	ABANDONMENT PLUC	115	LEAD	FRESH WATER		150	603	No
<u>PERFORATIONS</u>	<u>Formation</u>	<u>Zone</u>	<u>Top</u>	<u>Btm</u>	<u>Date</u>	<u>Reason</u>	<u>Comments</u>	
	SUSSEX		4400	4401	12/18/2013	CEMENT SQUEEZE		
	SUSSEX		5130	5131	12/18/2013	CEMENT SQUEEZE		
			7490	7491	03/22/2012	CEMENT SQUEEZE		
	J SAND		8017	8027	05/03/1976	PRODUCTION		
	J SAND		8018	8024	05/04/1971	PRODUCTION	4 holes	
	J SAND		8034	8050	05/04/1971	PRODUCTION	9 holes	
	J SAND		8034	8063	05/03/1976	PRODUCTION		
	J SAND		8056	8060	05/04/1971	PRODUCTION	3 holes	

**Comments:**