


# WELLBORE DIAGRAM

**Tekton Windsor LLC**  
**Rancho Water Valley 11 #7-7-33-270-6-CH**  
 NENE Sec 4-T5N-R67W  
 SHL: 220' FNL, 366' FEL  
 BHL: 665' FSL, 459' FWL  
 Weld County, CO  
 05-123-36428

Updated:  
 7/24/2013  
 JRR

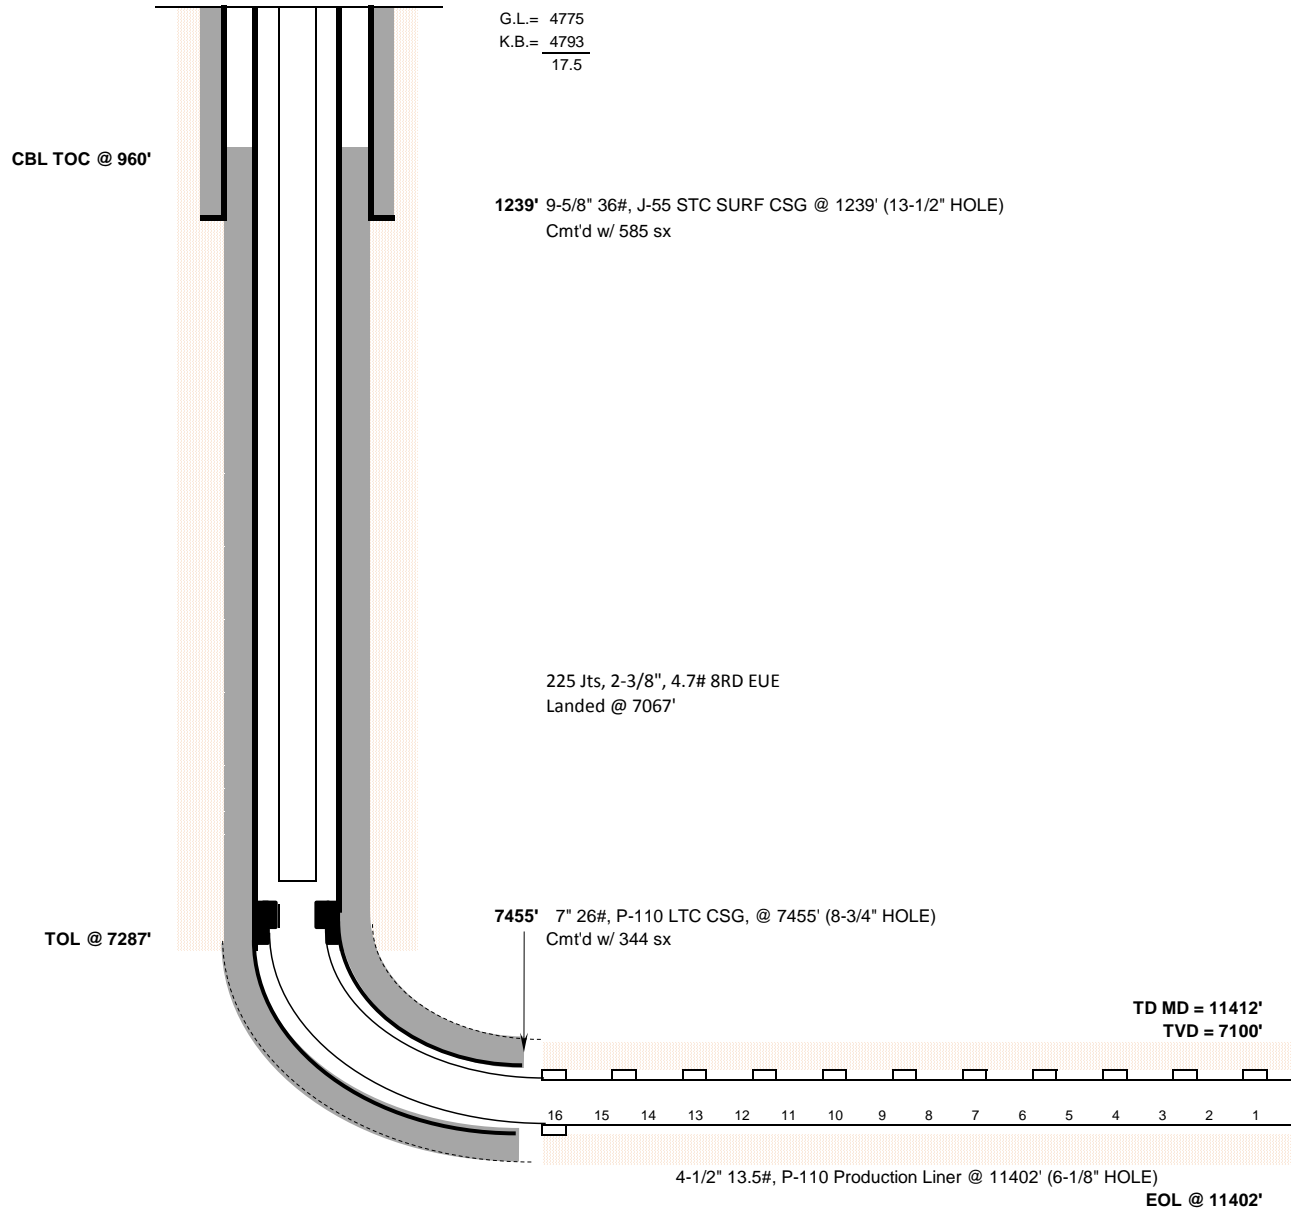

## COMMENTS:

4-1/2" LNR PKR @ MD: 16 @ 7494', 15 @ 7728', 14 @ 8003', 13 @ 8233', 12 @ 8464', 11 @ 8698', 10 @ 8972', 9 @ 9205', 8 @ 9433', 7 @ 9669',  
 6 @ 9946', 5 @ 10183', 4 @ 10417', 3 @ 10651', 2 @ 10889', 1 @ 11123'  
 4-1/2" LNR SLEEVES @ MD: 16 @ 7632', 15 @ 7863', 14 @ 8136', 13 @ 8373', 12 @ 8601', 11 @ 8835', 10 @ 9109', 9 @ 9340', 8 @ 9572', 7 @ 9807',  
 6 @ 10086', 5 @ 10320', 4 @ 10554', 3 @ 10792', 2 @ 11026', 1 @ 11263'