

WPX Energy Rocky Mountain LLC

FEDERAL RU 42-5


RULISON Field

SHL 240' FNL 2620' FWL (SE/4 NW/4) LOT 2 Section 5 T7S R93W 6th PM

BHL 1222' FNL 700' FEL (NE/4 SE/4) Section 5 T7S R93W 6th PM

Garfield County Colorado

**Formation Tops
(Measured Depths)**

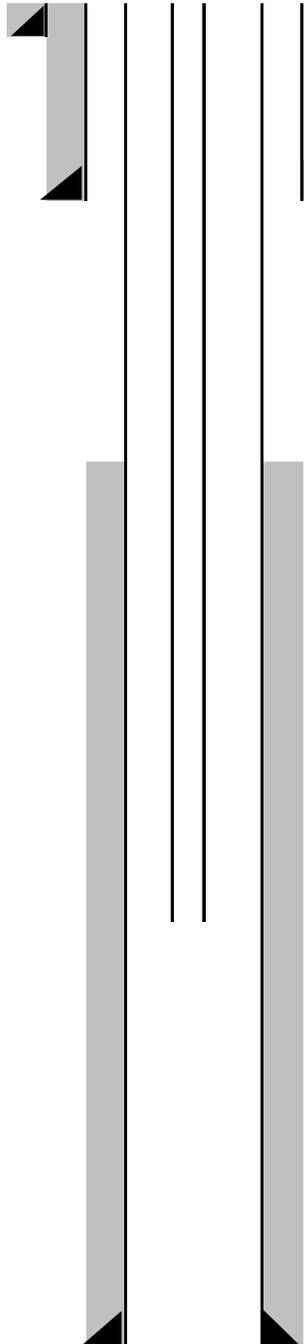

Conductor 26" Hole 18" casing/liner 42' W/ 16 Sks cmt

Cmt @ Surface - (Cmt circ to surf during cmt job)

9-5/8" 32.3 ppf Csg. Set @ 1162'

In 13-1/2" Hole W/ 320 Sks. Cmt

Top Of Cement @ 6764'

"G" Sand @ 3898'

Mesaverde @ 6555'

Cameo @ 9386'

Rollins @ 10197'

Tubing String: 2-3/8" Set @ 9787'

8255-8380' Mesaverde

8421-8653' Mesaverde

8724-8960' Mesaverde

9036-9272' Mesaverde

9346-9604' Cameo

9696-9967' Lower Cameo

PBTD @ 10187'

TMD @ 10367'

TVD @ 9957'

4-1/2", 11.6 ppf. Csg. Set @ 10356' W/ 1040 Sks Cmt

DATE CREATED: 1/27/2014

NOTE: THIS IS NOT TO SCALE.

FINAL