

WPX Energy Rocky Mountain LLC

WPX ENERGY RWF 32-4


RULISON Field

SHL 425' FNL 1684' FEL (NW/4 NE/4) Section 4 T7S R94W 6th PM

BHL 2030' FNL 1991' FEL (SW/4 NE/4) Section 4 T7S R94W 6th PM

Garfield County Colorado

Formation Tops
(Measured Depths)

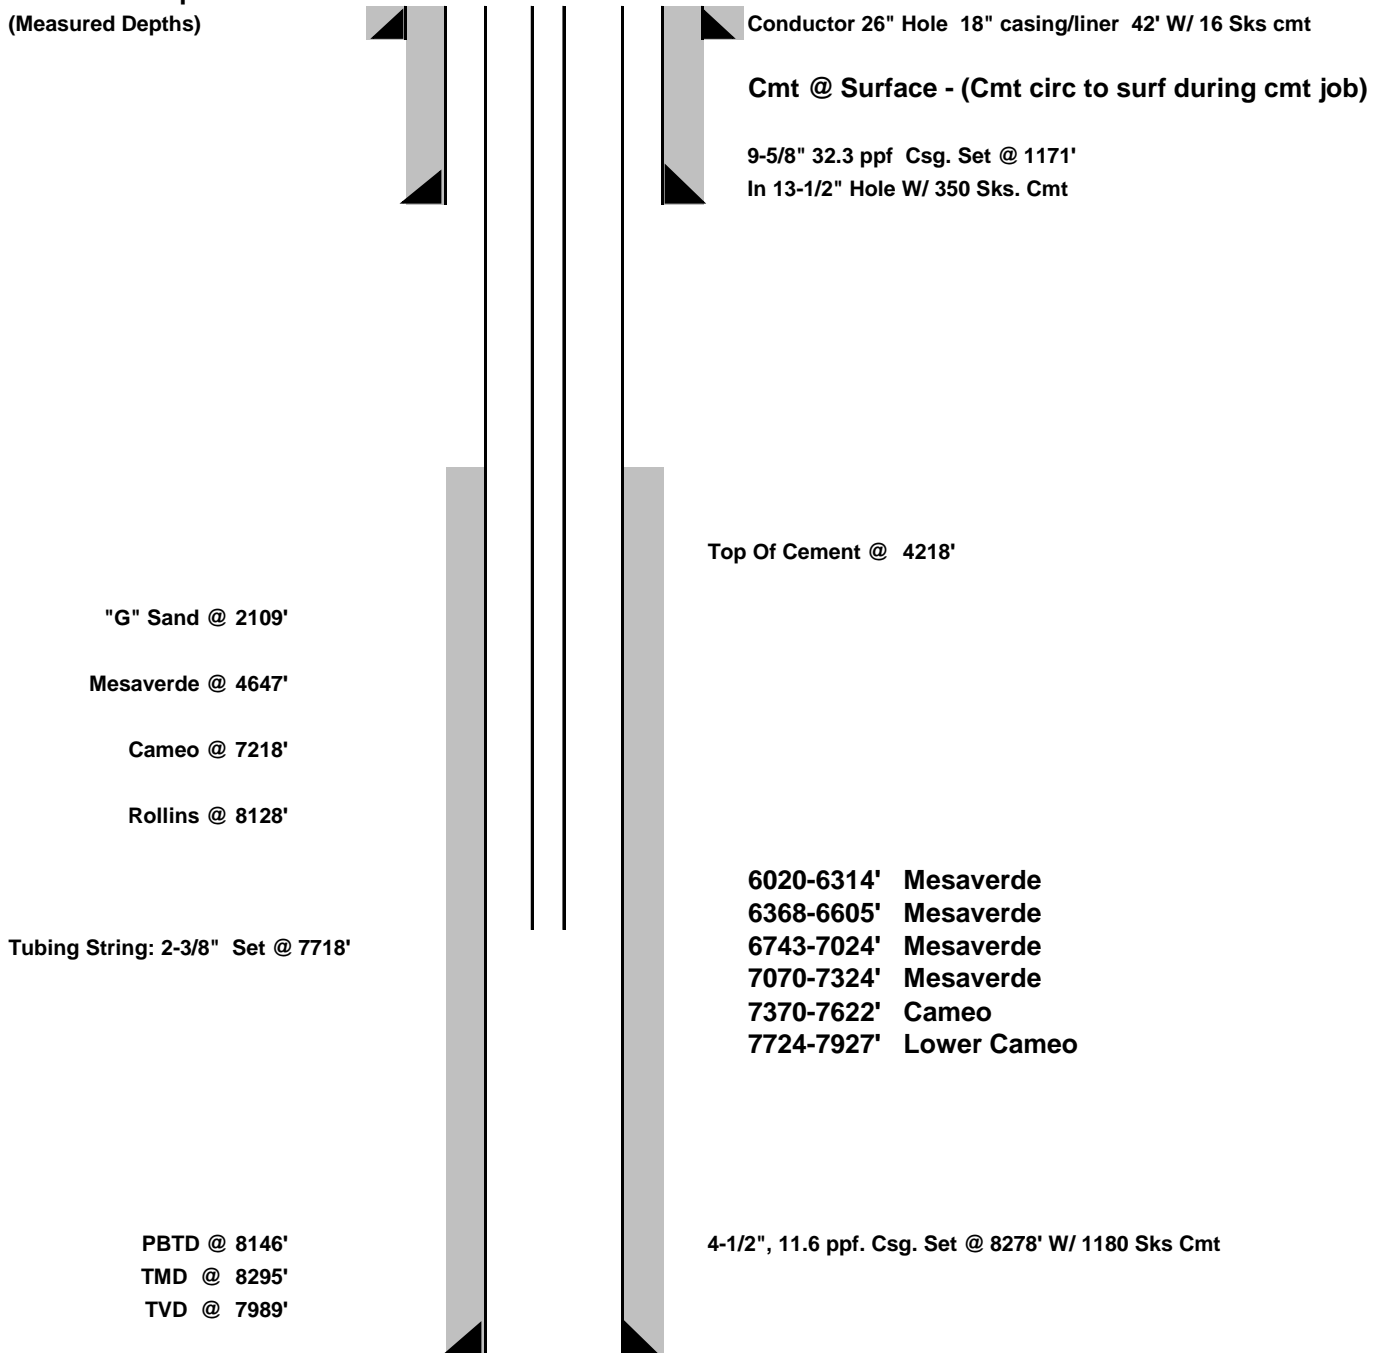

DATE CREATED: 1/21/2014

NOTE: THIS IS NOT TO SCALE.
****FINAL****