

**WPX Energy Rocky Mountain LLC**

**FEDERAL PA 513-12**

**Parachute Field**


**SHL 2588' FSL 1730' FWL (NE/4 SW/4) Section 12 T7S R95W 6th PM**

**BHL 1558' FSL 675' FWL (NW/4 SW/4) Section 12 T7S R95W 6th PM**

**Garfield County Colorado**

**Formation Tops**

(Measured Depths)

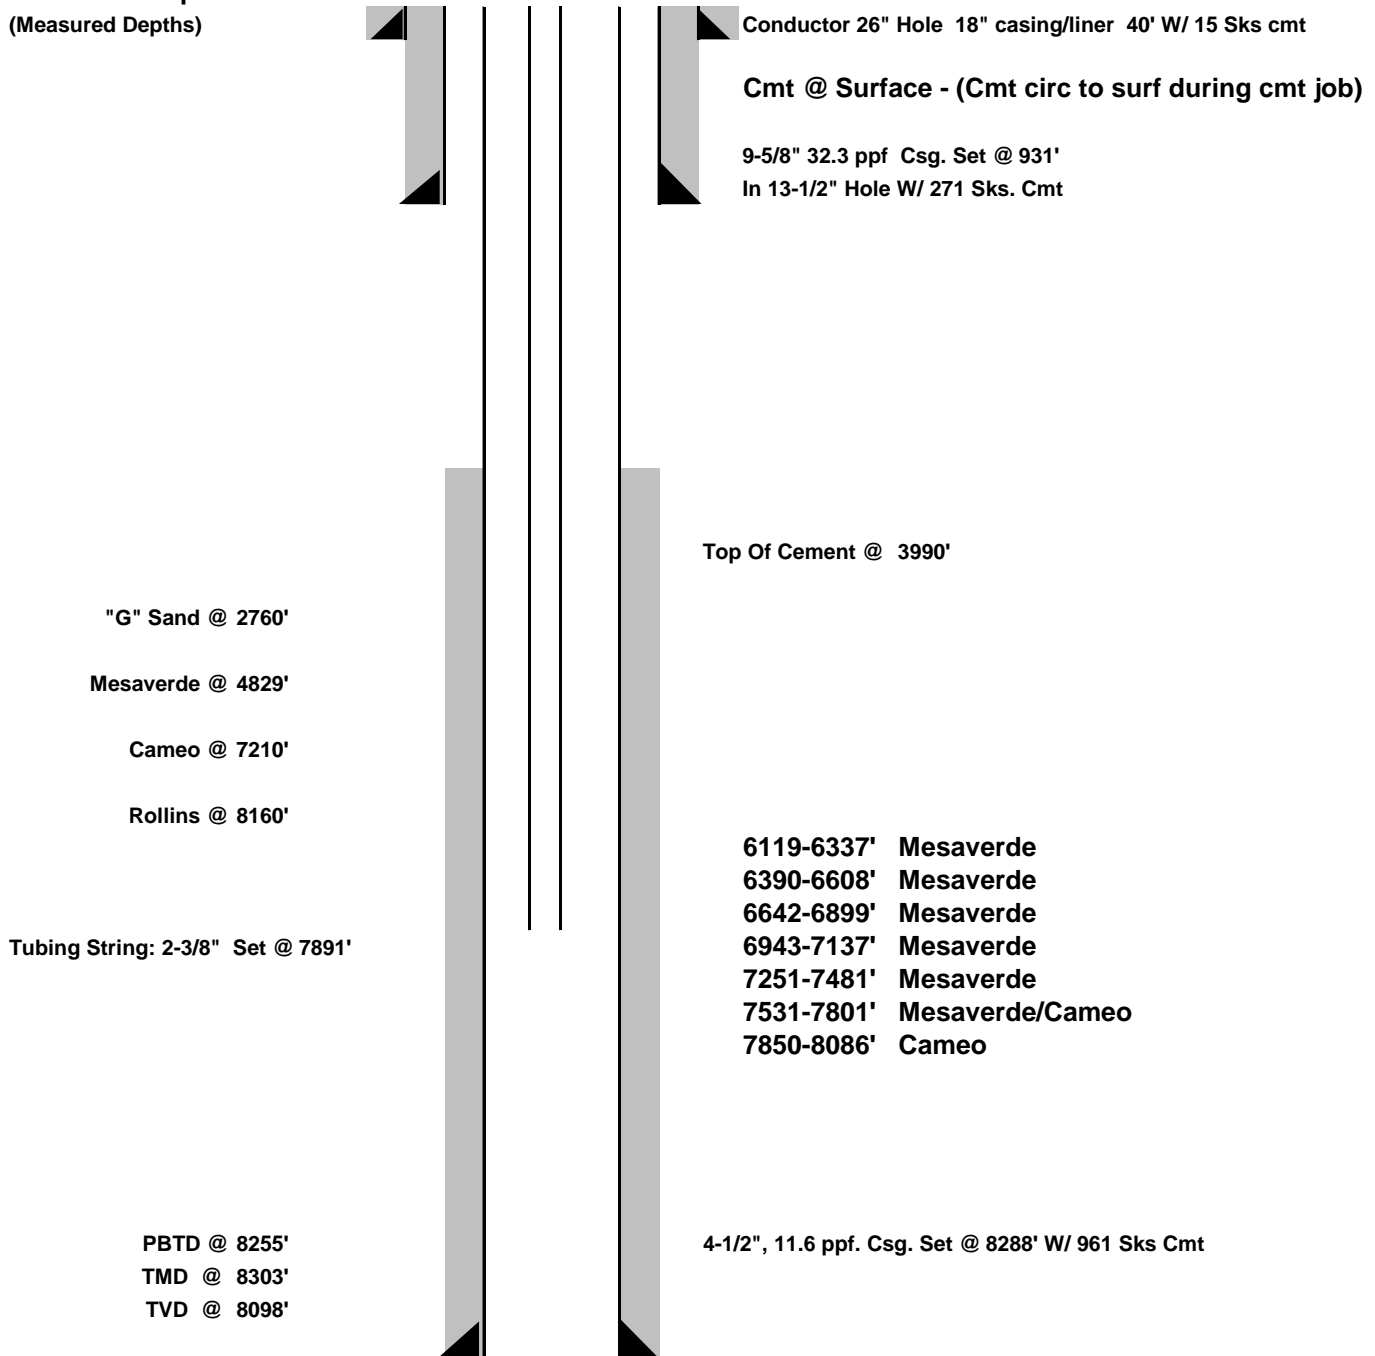

**DATE CREATED:** 1/20/2014

**NOTE: THIS IS NOT TO SCALE.**

**\*\*FINAL\*\***