

Physical Address: 345 Comanche St.  
Mail to: Box 384 Kiowa, CO 80117  
Ph. 303-621-8672 - Fax 303-621-7749  
www.highprairiesurvey.com


Job # 14006 SNOW KING #13-33

Inv # 2942

High Prairie Surveying of Kiowa, Colorado, in accordance with a request from Nighthawk Production LLC, has determined the location of SNOW KING #13-33 (Top Hole Location) to be 312 feet FSL, and 737 feet FWL, and SNOW KING #13-33 (Bottom Hole Location) to be 620 feet FSL, and 640 feet FWL (90° off Section lines) of Section 33, Township 6s, Range 54w of the 6th Principal Meridian, Lincoln County, Colorado.

Date: Staked on 01/13/14 drawn on 01/14/14.

Re: Staked by Elijah Frane  
Drawn: Drawn by Dustin Cotter

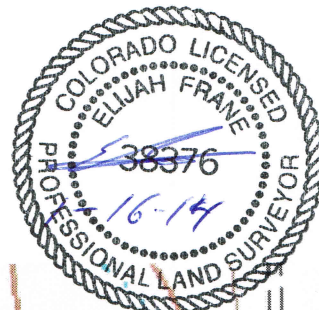

## Access Road Map

